

NOTICE OF INTENTION TO DRILL

*DIST BAC
Sal
Dmz
Kriau
Ston
Mendenhall
Reid's
Peg.*

Starting date November 1, 1983
Month Day Year

API Number 15-189-20,682
C NE NW Sec. 22 T 31 S. R. 35 West
660 ft. from N or line of section
1980 ft. from W or line of section

Operator license # 5208
Operator Mobil Oil Corporation
name Attn: L.C. Case; P.O. Box 5444
address Denver, CO 80217

Nearest lease or unit boundary line 660 feet
County Stevens

Contact person L. C. Case
Phone (303) 298-2046
Contractor license # 8154

Lease name M. L. Reynolds Unit "C" Well # 8
Surface pipe by alternate 1 or 2 _____
Domestic well within 300 ft. yes; Municipal well within one mile yes
 no no

Contractor name & address Lanex, Inc., Lakepoint Tower, W. 4013 NW Expressway, Suite 610 Oklahoma City, OK 73116

Depth of fresh water 575 feet
Lowest usable water formation Dakota **THIS PERMIT**
Depth to bottom of usable water 600 feet

Type equipment: rotary air _____ cable _____
Well drilled for: oil gas _____ SWD _____
In OWWO
Well class: infield pool ext _____ wildcat _____

*Surface pipe to be set 625 feet
Conductor pipe if any required None feet
Ground surface elevation 2990 feet MSL.
Est. total depth 6250 feet

APR 11 1994
EXPIRES

*Surface pipe will be set 25' below White Horse Sandstone

I certify that we will comply with K.S.A. 55-101, et seq., plus eventually plugging back to KCC specs.
Date 10/3/83 Signature of operator or agent _____

L. C. Case Division Regulatory Engineer

Date received 10-11-83

To be filed with Kansas Corporation Commission 5 days prior to commencing well.
Card to be typed

MHC/KOHE 10/11/83 form C-1 483

MAILED

OCT 12 1983

REMEMBER TO


CONSERVATION DIVISION
WICHITA, KANSAS

1. Notify District office before setting surface casing.
2. Set surface casing by circulating cement to the top.
3. File completion forms ACO-1 with KCC within 90 days of well completion, following instructions on Page 2, side 2 and including copies of wireline activities.
4. Notify District office 48 hours prior to old well workover or re-entry.
5. Prior to plugging, prepare a plugging plan, then obtain agreement from the appropriate district office for an approved plugging plan.
6. Submit plugging report (CP-4) to KCC after plugging is completed.
7. Obtain an approved injection docket number before disposing of salt water.
8. Notify KCC within 10 days when injection commences or terminates.
9. If an alternate 2 completion, cement in the production pipe from below any usable water to surface within 90 days of spud date.


WELL LOCATION SURVEY

PROPERTY OWNER Mobil Oil Corporation SURVEY OF WELL "M. L. Reynolds B#8
LOCATED 1980.00 feet from the West Line and 660.00 feet from the North Line
SECTION 22, T31S-R35W COUNTY OF Stevens STATE OF Kansas
SURVEYED September 23, 1983 PLATTED September 26, 1983

ELEVATION OF WELL LOCATION IS 2989.60 feet

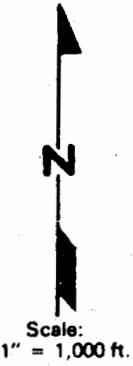

B#8 → C#8
10-13-83

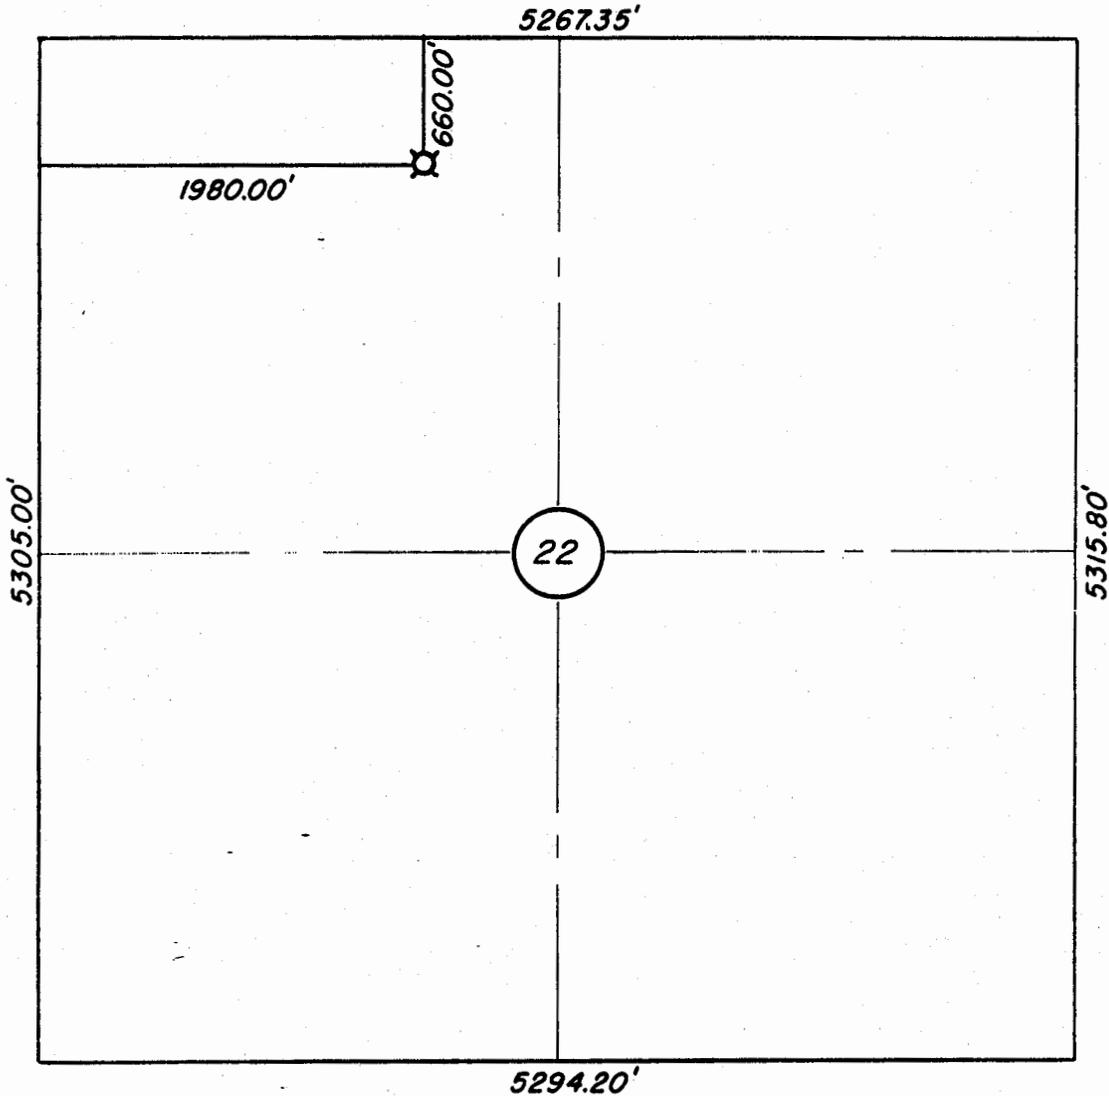

William Tim Campbell being a Registered Land Surveyor
in the State of Kansas Seal No. 766 do hereby certify that the above plat represents an accurate
survey made under my supervision and that all measurements, bearings and monuments are correctly shown and indicated on the above
plat as found or staked in the field as so dated above.

Surveyed by: Tim Campbell
and Don DeSpain

Signed: William Tim Campbell

Book 655 Page 62



Surveying - Engineering - Drafting
Company
Guymon, Oklahoma 73942
Box 1214 Phone: Day 333-6904 or 338-2144
338-7781 and 333-2656

Plat No. 558