

WELL INFORMATION/COMPLETION REPORT

CTL: 144CO

22-31-35

WRT NO. 86-14-130

☒ INFO

IN ONLY

☐ COMPLETION

FIELD UNIT DENVER E&P

SECTION LOCATION 1-26485	TITLE RECORDS NUMBER KS-7927	WELL NUMBER #6	LEASE NAME M.L. REYNOLDS UT. "B"
L. NO. 62	YEAR COMPLETED 1984	*FPC PRICING AREA 65	*JOINT ACCT. SURVEY AREA 67
*FPC LEASE CATEGORY 69		STATE NO. 76	
D NAME S. CUTTER		FIELD NO. 70	STATE KANSAS
NTY NAME STEVENS		*COUNTY NO. 78	DATE STARTED 2/1/84
		DATE COMPLETED 3/13/84	

DESCRIPTION OF LEASE ON WHICH WELL(S) LOCATED

CNTR SW 1/4 SEC. 22-31-35W

WELL DRILLED OR WORKED ON AS 33-	WELL COMPLETED AS (1) ☒ SINGLE (2) ☐ MULTIPLE TYPE -35-	TOTAL DEPTH DRILLED -37- 39- 43	Denver WELL COSTS Oil & Gas Inst. Dept.
☐ EXPLORATORY ☐ DEVELOPMENT ☐ COMB. - EXPL. & DEVL. ☐ DRILL DEEPER ☐ RE-ENTRY ☐ FLUID INJECTION ☐ SERVICE WELL ☐	(1) ☒ OIL (2) ☐ GAS (3) ☐ OIL & CASINGHEAD GAS (4) ☐ GAS & CONDENSATE (5) ☐ OIL & GAS (6) ☐ OIL, GAS, & CONDENSATE (7) ☐ OIL & CASINGHEAD GAS, GAS & CONDENSATE (8) ☐ DRY (9) ☐ OTHER	(1) ☐ 0-1,250 (2) ☐ 1,251-2,500 (3) ☐ 2,501-3,750 (4) ☐ 3,751-5,000 (5) ☒ 5,001-7,500 6175 (6) ☐ 7,501-10,000 (7) ☐ 10,001-12,500 (8) ☐ 12,501-15,000 (9) ☐ OVER 15,000	INTANGIBLE 100% 44-50 MOBIL'S SHARE 51-57 EQUIPPING 100% 58-64 MOBIL'S SHARE 65-71 MOBIL'S NET FOOTAGE 72-76 MOBIL'S OWNER- SHIP INTEREST IN WELL 77-80 *CLOSED IN VOUCHER

☐ COMPLETION ☐ ACQUIRED ☐ RECOMPLETION	FIRST WELL ON LEASE ☐ YES ☐ NO	PLUG BACK TOTAL DEPTH FT.	DEVELOPMENT TO FT.	EXPLORATORY FT.	PRODUCING DEPTHS
☐ CONVERTED ☐ SHUT-IN	☐ RECLASSIFIED ☒ INCAPABLE OF PRODUCING	☐ PRODUCTION RESUMED ☐ ABANDONMENT	☐ DISPOSED OF TEMP ☐ OTHER (SPECIFY) ABANDONMENT		

REASON FOR: WELL HAS BEEN S.I. SINCE 3/1/83 (SEE DENVER W.I.R. REPORT #257) WELL
SHOULD NOW BE CLASSIFIED AS T/A'D.TYPE OF LEASE: FEDERAL INDIAN OTHER X ON-SHORE X OFF-SHORE
WPR CONTROL NO. 26485-000-030 LAST WELL FOR LOCATION CODE: YES NO X

DATE 8/9/86	LAST WELL ON LEASE ☒ NO ☐ YES	IF NO, remaining wells are: ☐ OIL ☐ GAS ☐ GAS CONDENSATE ☐ GAS IF YES, is lease perpetuated by production from another portion of base lease? ☐ YES ☐ NO IF YES, show descriptions of other part of base lease and name of operator on reverse side.
----------------	---	--

DIL WELLS ONLY	☐ FLOWING ☐ ARTIFICIAL LIFT ☐ PUMPING	TANK NOS. (IF AVAIL.) 919, 911, 936, 937, 938 + 939	TRANSPORTER JAYHAWK PIPELINE
CHANGE IN AND/OR NEW DISPOSITION OF GAS, ETC.		TYPE OF SEPARATION ☐ WELL ☐ CENTRAL FACILITY ☐ LEASE W/OTHER WELLS	

GAS	☐ FIRST DELIVERY	DATE	PURCHASER
	☒ LAST DELIVERY	DATE 1/15/85	PURCHASER JAYHAWK PIPELINE
GAS	☐ FIRST DELIVERY	DATE	PURCHASER OR FACILITY
	☐ LAST DELIVERY	DATE	PURCHASER OR FACILITY
TYPE OF CONNECTION ☐ PERMANENT ☐ TEMPORARY		PRICE MCF	METER STA. NO.
OTHER BASIS (FLAT RATE, ESTIMATED PRICE)			

TO BE COMPLETED BY ACCOUNTING CENTER

Additional information, including diagrams, where necessary use reverse side. (If more space required, submit attachment)

C.R. Magera

8/9/86

P-12-86

File

RECOMMENDED PERFORATIONS
(Print in black ink)

Date: 1/23/90

CC: D. Albrecht 402 Hirkoke
B. Dicus 402 Hirkoke
L.A. Jenkins 6E

COUNTY: Stevens FIELD: Panama STATE: KS


CORRELATION LOG AND DATE: DWL-SFL-GR, Schlumberger, 2/26/84

[illegible]

COMMENTS (Formation Sensitivity, adjacent zone problems, offset wells, etc.):

This well originally produced in South Cutter Field but has been T/A'd since 1985. It is recommended that the well be recompleted for Panama Field in the above listed intervals. The "B" zones should be opened, acidized, and tested before the "A" zone is opened. The upper B1 (2930-2936) appears to be water-bearing and should be avoided. This well is offset to the N and NE by Panama production and R/E of the Nora Leffler #1 (21-315-35W) is currently underway to the west.

APPROVAL: A. J. Dilling 1/23/90
Producing Geology Supervisor

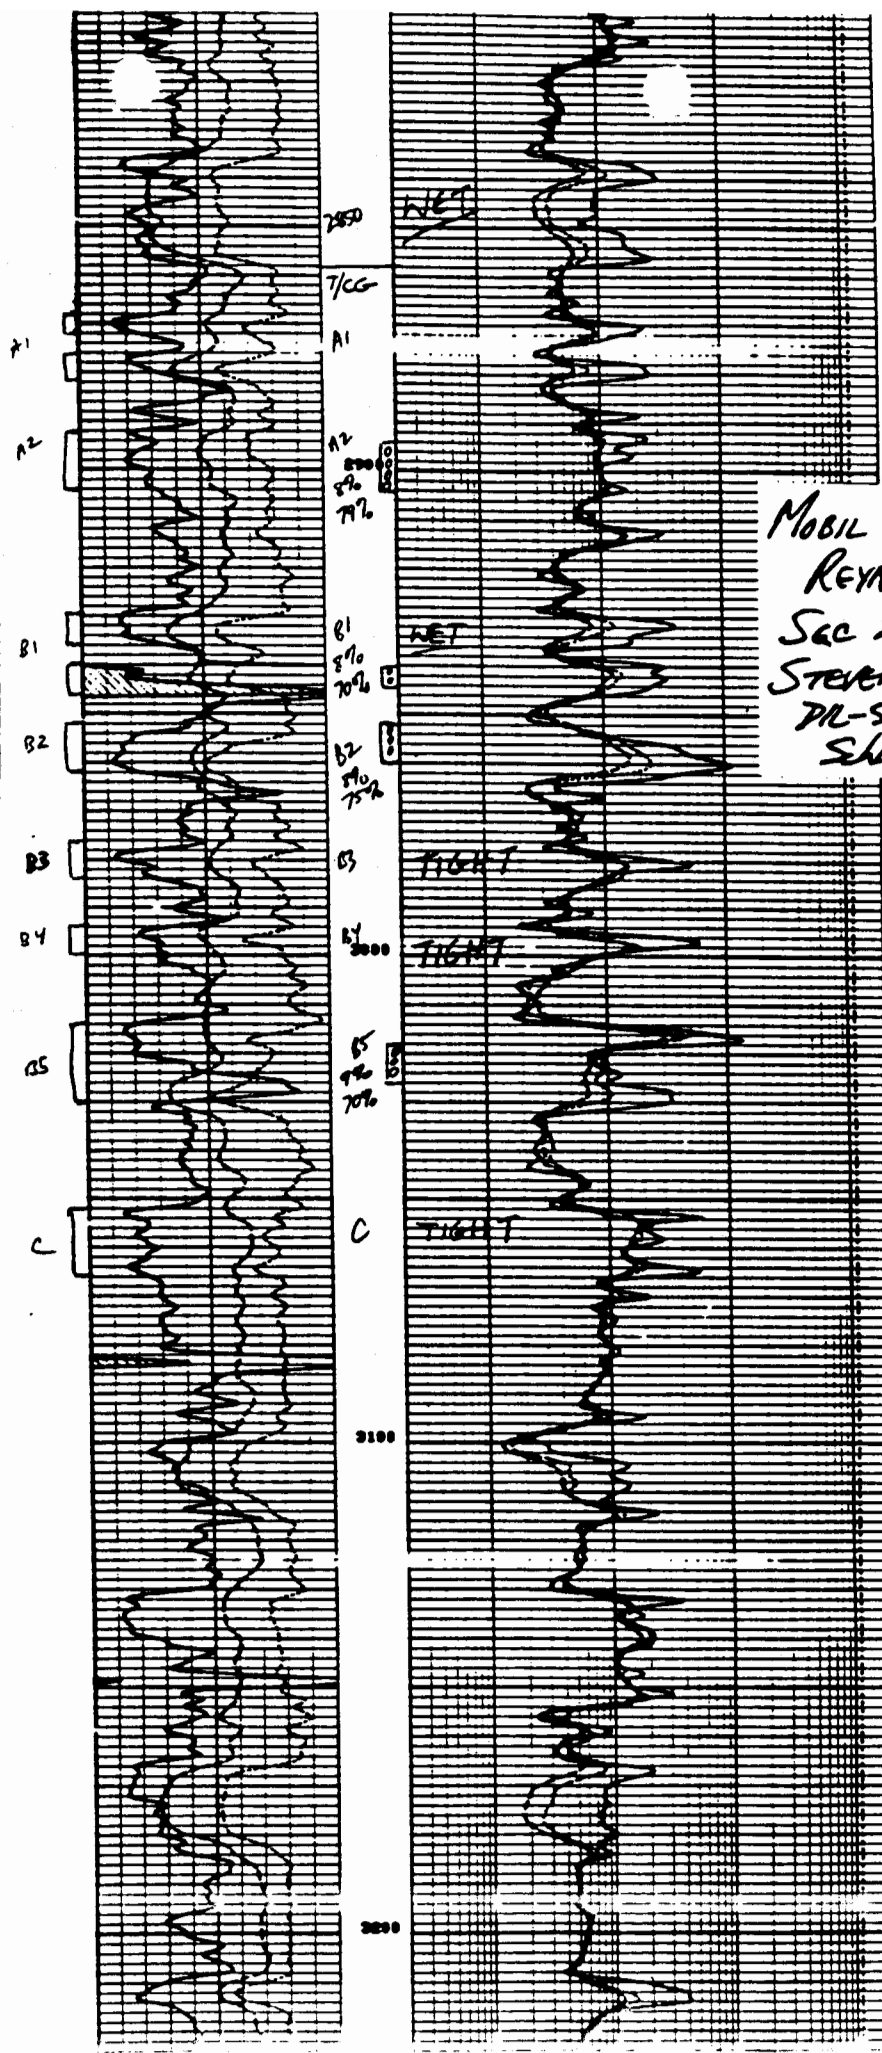

MOBIL M.L.
 REYNOLDS "B" #6
 SEC 22-31S-35W
 STEVENS Co, KS
 DL-SFL
 Schlumberger 2/26/84

This log is
 from the
 well being
 recompleted.
 Well name
 will change
 from M.L.-
 Reynolds "B"
 to
 M.L. Reynol.
 "B" #8.

Jackie
File
Change Any
Well List to well
As necessary well file
Also change well file
name as well.
JH

REW - Hickok

INTEROFFICE CORRESPONDENCE

Liberal Asset Team

Date: July 5, 1990

To: B. G. Wright - Liberal
P. O. DeVille - Liberal
S. K. Belmont - Liberal
G. D. Carlson - Liberal
L. A. Jenkins - Denver 6E
D. H. Smith - Denver 7G
M. R. Schechter - Hugoton
R. E. Wheeler - Hickok
J. H. Robles - Hugoton
L. R. Amsberry - Dallas 210
J. M. Woodmansee - Dallas 210
Well File

CC:

WELL NAME CHANGE
M. L. REYNOLDS "B" UNIT #8
LOCATION CODE NO. 13337
FORMERLY: M. L. REYNOLDS
"B" WELL #6
NE SW SEC. 22-31S-35W
STEVENS COUNTY, KANSAS

This is to advise that the well known as the M. L. Reynolds "B" Well #6 will be called the M. L. Reynolds "B" Unit Well #8. The subject well has been recompleted in the Panoma Council Grove. The Location Code will be #13337.

Please change your records to reflect this name change.

R. Kelly

R. Kelly

RKelly/rk
namechg