


Section 35 Township 31N Range 36W

Well No. #1 Mast

Company Magnolia

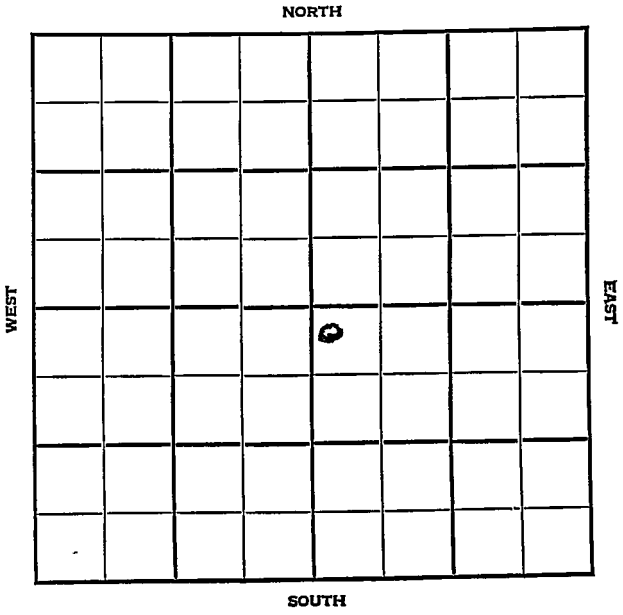

KANSAS

Steyens

Sec. 35 Twp. 31 R. 36W

Well No. #1 Mast Farm

Magnolia Company

Hugoton Pool

NORTH


330' Ft. from N. Line

_____ Ft. from S. Line

_____ Ft. from E. Line

200' Ft. from W. Line

NW SE

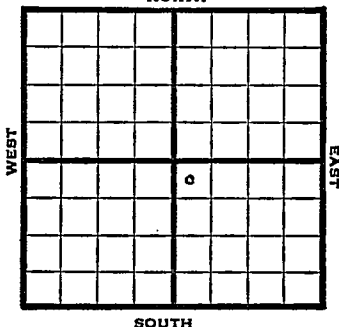

1948 Eli 3060' REPORT

6/9 10" @ 742'
WOG

6/16 TD 2900'
7 @ 2900'

6/23 240 shots 2776-2826 - 7000 acid

6/29 96 shots 2728-52 7000 acid
144 shots 2674-2708- 7000 acid

7/14 TD 2900'
7" @ 2900'
Perf 28000 acid
15,900,000 Gas
420# R Pr.
Comp

COMPLETED

Map No. _____ Sec. 35 Twp. 31 R. 36W

Well No. 1 Mast

Magnolia Company

FIRST REPORT Contractor

NW SE

SECTION PLAT

330 Ft. from N. Line

_____ Ft. from S. Line

_____ Ft. from E. Line

200 Ft. from W. Line

		o	

Stevens County

Location _____

Rig up _____

Drilling and Remarks:

10" @ 742 WOC

RECORD

Cased _____ in., _____ ft.

Sand _____

Gas _____

Oil _____

Total Depth _____

PRODUCTION

1st 24 hrs. Nat. _____

1st 24 hrs. after shot _____

Gas _____ Cu. Ft.

Dry Hole _____

Abandoned _____

Date

JUN 9 1948

19

S. J. LEWIS

Scout

Map No. _____ Sec. 35 Twp. 31 R. 36W

Well No. 1 Mast

Magnolia Company

COMPLETE

Contractor

NW SE

E. 13060
SECTION PLAT

330 Ft. from N. Line

_____ Ft. from S. Line

_____ Ft. from E. Line

200 Ft. from W. Line

		o	

Stevens County

Location _____

Rig up _____

Drilling and Remarks:

7" @ 2900

Perf.

28000 gals

15,900,000 gal

*420 * R/P*

RECORD

Cased _____ in., _____ ft.

Sand _____

Gas _____

Oil _____

Total Depth 2900

PRODUCTION

1st 24 hrs. Nat. _____

1st 24 hrs. after shot _____

Gas _____ Cu. Ft.

Dry Hole _____

Abandoned _____

Date

JUL 14 1948

19

S. J. LEWIS

Scout