

KANSAS

Stevens

FORM 51 IOM 12-46 PETROL

Section 35 Township 31 Range 37-W

Well No. 2 Lemert

Company Republic Natural Gas

Hugoton Pool

NORTH

				0			

WEST

EAST

SOUTH

Sec. 35 Twp. 31 R. 37-W

Well No. 2 Lemert Farm

Republic Natural Gas Company

Hugoton Pool


100 Ft. from N. Line

_____ Ft. from S. Line

_____ Ft. from E. Line

100 Ft. from W. Line

NW SE

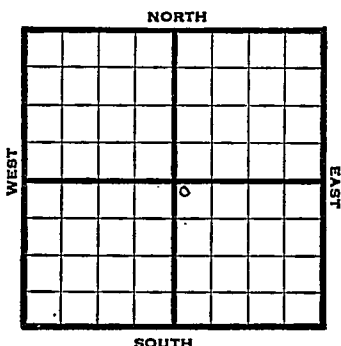

1947

Elev. 3102' REPORT

- 8/13 Loc.
- 8/20 10" @ 584'
Drlg 1815'
- 8/27 TD 2580'
7" @ 2571'
- 9/3 "
- 9/10 "
- 9/17 TD 2580'
- 9/24 "
- 10/1 TD 2773'
- 10/8 225' of 5" Perf liner @ 2773'
- 10/15 "
- 10/22 24000 acid
- 11/5 7" @ 2571'
225 of 5" Perf liner @ 2773'
Acid 24,000
Gas 38,439,000
Rock Pressure 405#
Total Depth 2773'

COMPLETED

Map No. _____ Sec. 35 Twp. 31 R. 37W

Well No. 2 Lemert

Republic Natural Gas Company

FIRST REPORT

Contractor _____

NW SE.

SECTION PLAT

100 Ft. from N. Line

_____ Ft. from S. Line

_____ Ft. from E. Line

100 Ft. from W. Line

		o	

Stevens County

Location X

Rig up _____

Drilling and Remarks:
 /

RECORD

Cased _____ in., _____ ft.

Sand _____

Gas _____

Oil _____

Total Depth _____

PRODUCTION

1st 24 hrs. Nat. _____

1st 24 hrs. after shot _____

Gas _____ Cu. Ft.

Dry Hole _____

Abandoned _____

Date

AUG 13 1947 19

S. J. LEWIS

Scout

Map No. _____ Sec. 35 Twp. 31 R. 37W

Well No. 2 Lemert

Republic Natural Gas Company

COMPLETE

Contractor

NW SE

E1,8102
SECTION PLAT

100 Ft. from N. Line

_____ Ft. from S. Line

_____ Ft. from E. Line

100 Ft. from W. Line

		6	

Stevens County

RECORD

Location _____

Cased _____ in., _____ ft.

Rig up _____

Sand _____

Drilling and Remarks:

Gas _____

Oil _____

Total Depth 2773

=====

PRODUCTION

1st 24 hrs. Nat. _____

1st 24 hrs. after shot _____

Gas _____ Cu. Ft.

Dry Hole _____

Abandoned _____

*7" @ 2571
225' of 5" Perf. lines
@ 2773
24000 cu. ft.
38,439,000 gal.
405 * R A*

Date

NOV 5 1947 19

S. J. LEWIS Scout