

Seward


KANSAS

SECTION 35 TOWNSHIP 31 RANGE 32W

WELL NO. #1 Woodward Gas Unit

COMPANY Michaelis Drlg.

NORTH

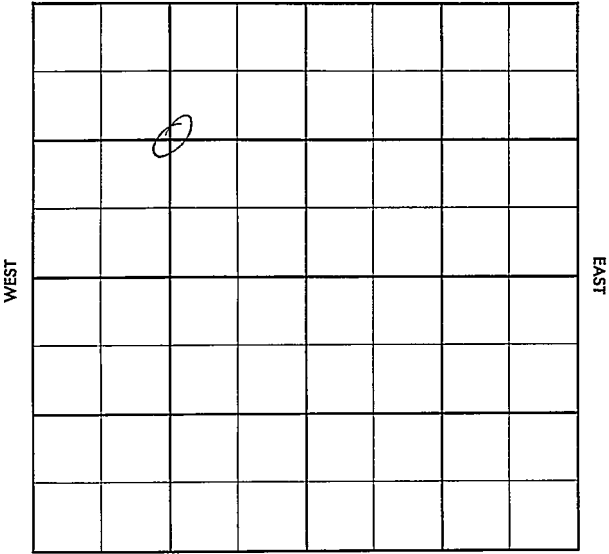

Seward

KANSAS

SEC.

35

TWP.

31

R.

32W

WELL NO.

#1 Woodward Gas Unit

FARM

COMPANY

Michaelis Drlg.

CONTRACTOR

Co. Tools

Hugoton


_____ Ft. from N. Line

_____ Ft. from S. Line

_____ Ft. from E. Line

_____ Ft. from W. Line

C NW/4

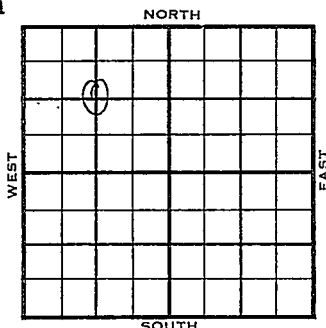

CRA, Ohio & H-P - FO

1956

ELEVATION

2841

REPORT

3-28

Comm. 3-22-56

8" @ 600 w/300

TD 2747

4" @ 2745

4-11

CO 80/ 2690-2710, 48/ 2660-72,

40/ 2640-50, frac,

Comp. 5380 mcf/gpd

Log tops:

Herr. 2630

U. Kri. 2656

L. Kri. 2688

Wfd. 2740

TD 2747

COMPLETED

County Seward Elev. _____
 Sec. 35 Twp. 31 Rge. 32W
 Company Michaelis Drig.
 Farm Name Woodward Gas Unit No. 1

TOPS	DEPTH	LOG	DATUM
Anh.			
Tr.			
H.			
Tr.			
Dg.			
BL.			
L.			
K.C.			
B.K.C.			
Ce.			
C.			
M.			
M.			
K.			
Mz.			
Mq.			
V.			
S.			
S.			
A.			
R.			
PE.			
G.			
T.D.			

Loc. in Sec.

G NW/4

Geol. _____

Contr. _____

Co. tools _____

Pool _____

Hugoton

FIRST REPORT

MAR 28 '56

Date Comm. 3-22-56 GRA, Ohio & H-P - FO
8" @ 600/300 TD 2747 4" @ 2745

Co.

Lse.

No.

Sec.

T.

R.

County Seward Elev. 2841
 Sec. 35 Twp. 31 Rge. 32W
 Company Michaelis Drlg.
 Farm Name Woodward Gas Unit No. 1

TOPS	DEPTH	LOG	DATUM
Anh. <u>Heir</u>		<u>2630</u>	
Tp. <u>OKri</u>		<u>2656</u>	
H. <u>LKri</u>		<u>2688</u>	
Tr. <u>Wfd</u>		<u>2740</u>	
Dg.			
BL.			
L.			
K.C.			
B.K.C.			
Ce.			
C.			
M.			
M.			
K.			
Mz.			
Mq.			
V.			
S.			
S.			
A.			
R.			
PE.			
G.			
TD.	<u>2747</u>		

Loc. in Sec.

C NW/4

Geol.

Contr.

Co. tools

Pool

Hugoton

COMPLETE

Date Comm. 3-22 -56 APR 11 1956

8" @ 600/300 TD 2747 4" @ 2745

CO 80/ 2690-2710 48/ 2660-72

40/ 2640-50 frac Comp. 5,380 mcfgpd