


Barber

KANSAS

SECTION 35 TOWNSHIP 31 RANGE 15W

WELL NO. #2 Skinner "B"

COMPANY N C R A

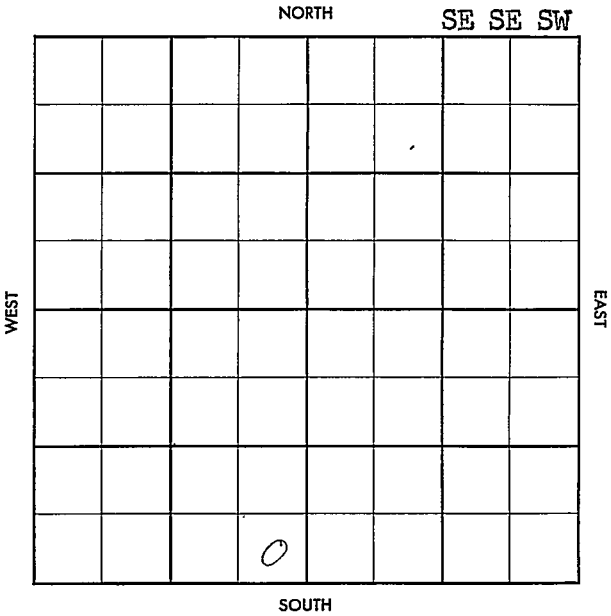

County Barber Elev. 1910Sec. 35 Twp. 31 Rge. 15ECompany N. C. R. A.Farm Name Skinner "B" No. 2

TOPS	DEPTH	LOG	DATUM	Loc. in Sec.
Anh.				SE SW
TP.				
H.	<u>3959</u>			
Tr.	<u>3998</u>			
Dg. <u>32</u>	<u>4052</u>			
Bl.				
L.	<u>4150</u>			Geol.
K.C.				Contr.
B.K.C.				<u>Alward Dr.</u>
Ce.				
C.				Pool
M.	<u>4692</u>			<u>Donald</u>
M.				
K.	<u>4742</u>			
Mz.				
Mo.				
V.				
S.				
S.				
A.				
R.				
PC.				
G.				
TD.	<u>4780</u>			

COMPLETE

JUL 3 '57

0

Date Comm.

Location W 55° 6-3-57 85/81100 5785/8 231/175 D 3777 JUL 3 57DST 4221-20 1hr 300' GIPrel 32' HOCM BHP 20/20"DST 4693-4720 1hr 300' GIPG/2" ga 2,930 MCF/5" ga3,490 MCF/9" 4,70 MCF/15"stabil @ 3,920 MCF/30" rel

25' 56 CM FP 745-745
 BHP 620/20" DIT 4720
 -47 1 hr ga 4,640 MCF/15"
 stabil @ 5,210 MCF/30" new
 45' 56 CM FP 1240-1240
 BHP 1675/20" 5 1/2 @ 4772/250
 MCF "L" '57 CO 4741 ~~#~~ 176/
 4682-4726 Δ ga 5,500
 MCFE FRC 40 x 30
 C.50. calc of FLOW
 18 MILL CEGPD