


Haprer KANSAS

DX 78-1

Section 36 Township 31 Range 9W
Well No. 2 Campbell
Company Pickrell Drlg.

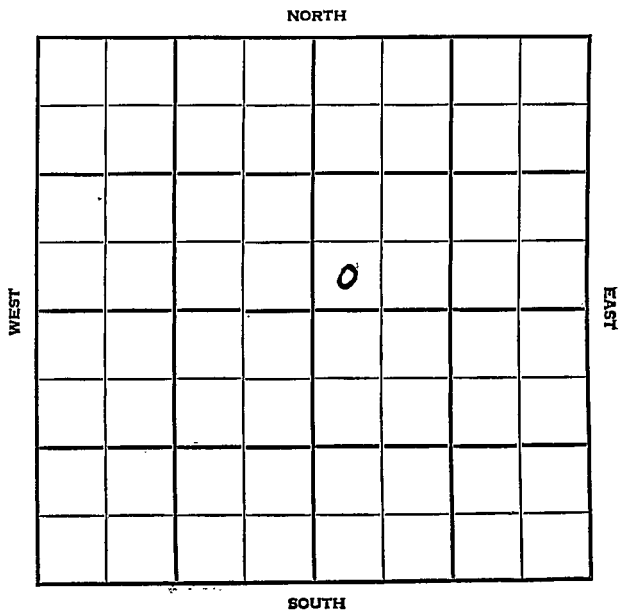

Harper

KANSAS

SEC.	TWP.	R.
36	31	9 W

WELL NO.

2 Campbell

FARM

COMPANY

Pickerell Drlg.

CONTRACTOR

Pickrell

S. Grabbs Pool

NORTH


Ft. from N. Line

330 Ft. from S. Line

Ft. from E. Line

330 Ft. from W. Line

SW SW NE

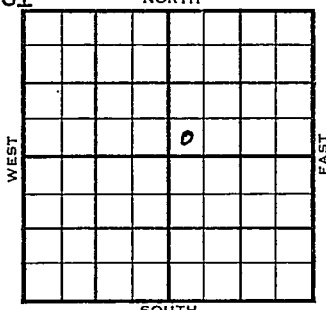

1954

ELEVATION

1523'

REPORT

8/4

Spud 7-28-54

8" @ 120

Brlg. 3100'

10/13

Spud 7-28-54 Oil well TD 4459

8" @ 120 Heeb 3378 Lans 3617

KC 3880 Miss 4348 TD 4459

Schl: Lans 3618' KC 3866' Miss 4342

5" @ 4441 Co to 4440 24/4348-54

DST 4351-59 open 1 hr gas in 32 min

rec 45' 0 & GCM, 90' HO & Gassy mud.

30' SW 1260#

DST 4359-69 open 1 hr ~~re~~ gas in 32 min

rec 90' 0 & GCM, 60' hvy oil & GCM

60' SW 1320#

DST 4369-84 open 1 hr rec 960' OCGW

1360# TD 4459 S & F/9 BFPH 70% wtr.

Comp. 29 BOPD 79% wtr.

COMPLETED

J. G. McGEHEE

FABEN GILSTRAT