


Section 36 Township 31 Range 9 W
Well No. # 1 Rall
Company British-American

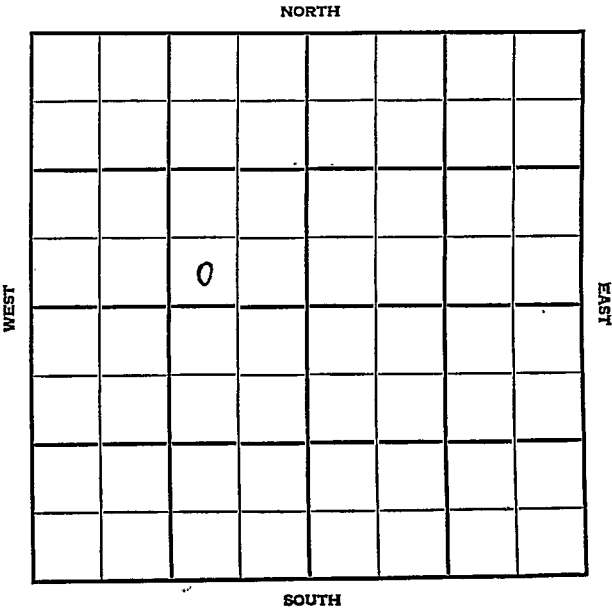

Harper KANSAS

SEC.	TWP.	R.
36	31	9 W

WELL NO. # 1 Rall FARM

COMPANY

British-American

CONTRACTOR

Big X Drlg.
Grabs Pool


Ft. from N. Line

330 Ft. from S. Line

990 Ft. from E. Line

Ft. from W. Line

SW SE NW

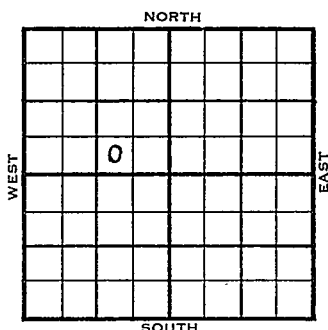

	ELEVATION	REPORT
1954	1563'	


12/22 Spud 12-17-54
10" @ 260
Drlg. 2017'

1955
1/5 Spud 12-17-54 D & A TD 4445
10" @ 260 Heeb 3403 Tor. 3414
Doug 3557 Lans 3659 KC 3917
Miss. 4407'
DST 4407-10 open 1 hr rec 30' mud.
DST 4412-45 open 1 hr rec 540' HGCM
944' SOCSW 1245# TD 4445'
D & A

ABANDONED

FACER: GILSTRAP

County Harper State Kansas
 Sec. 36 (Blk.) 31 (Sur.) 9W Map No.
 Operator British-American
 Well No. 1 Farm Rall
 Elev. 1563 Location SW SE NW

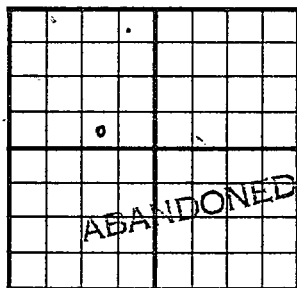

330 Ft. From S Line NW
990 Ft. From E Line Quarter
 Ist. Report
 Completion JAN 5 1955
 Remarks Grabs Pool
Big X Drlg. - Contr.
 Spudding Date 12-17-54

Drlg. Data D & A TD 4445
10" @ 260 Heeb. 3403 Tor. 3414
Doug. 3557 Lans. 3659 KC 3917
Miss. 4407 DST 4407-10 open 1 hr.
Rec. 30' mud DST 4412-45 open 1 hr.
Rec. 540' hgcm 944' socsw 1245#
TD 4445

D & A

FABEN GILSTRAP