
DX-78-1 Harper KANSAS

Section 36 Township 31 Range 9W

Well No. #1 Clifton Newberry

Company Purcell & Mull

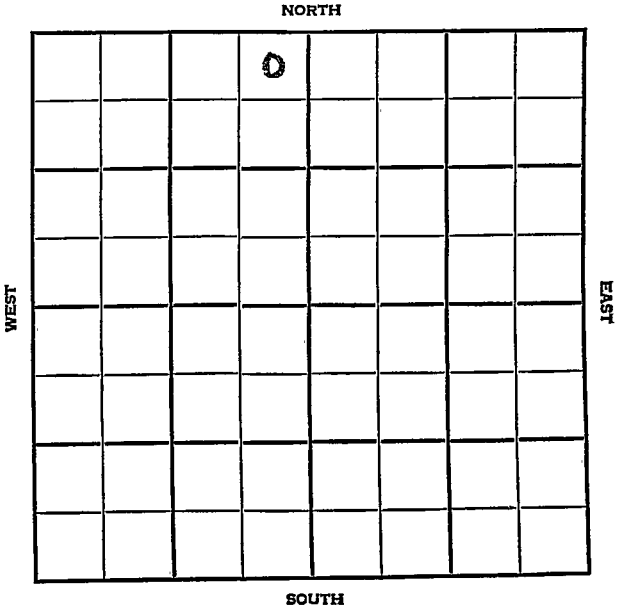

Harper **KANSAS**

SEC.	TWP.	R.
36 ~~33~~	31	9W

WELL NO.
1 Clifton Newberry FARM

COMPANY
Purcell & Mull

CONTRACTOR
Co. Tools

Grabs Pool


330' Ft. from N. Line

Ft. from S. Line

330' Ft. from E. Line

Ft. from W. Line

NE NE NW

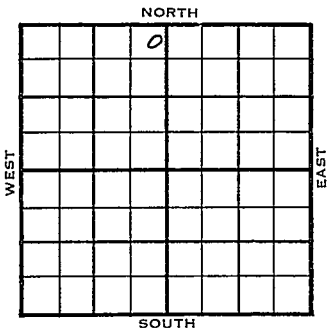

1955	ELEVATION 1532	REPORT
5/25	Spud 5-23-55 8" @ 216 WOC	
7/27	Comm 5-23-55 Miss 4341 TD 4351 8" @ 216 DST 4343-51 open 2 hr Rec 295' o & ocm 10' muddy wtr. 1260/20" 5 1/2" @ 4351 30/4344-49 250 A frac F/11 boph 15 hr F/43 bo 12 hr Comp F 354 bopd 2% wtr.	

COMPLETED

DX-78

FORM 275 FOR SALE BY KANSAS BLUE PRINT CO.


County Harper State Kansas

Sec. 36 (Blk. Twp.) 31 (Sur. Rge.) 9W Map No.

Operator Purcell & Mull

Well No. 1 Farm Clifton Newberry

Elev. Location NE NE NW

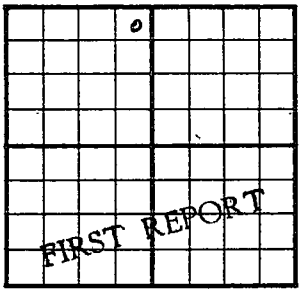

330 Ft. From N Line NW

330 Ft. From E Line Quarter

1st. Report MAY 2 5 1955

Completion

Remarks

Co. tools

Spudding Date 5-23-55

Drlg. Data Grabs Pool

8" @ 216 WOC

K-27

FORM 513 REV. SUNRAY

County Harper Elev. 1532

Sec. 36 Twp. 31 Rge. 9W

Company Purcell & Mull

Farm Name Clifton Newberry No. 1

TOPS	DEPTH	LOG	DATUM
Anh.			
Tp.			
H.			
Tr.			
Dg.			
Bl.			
L.			
K.C.			
B.K.C.			
Ce.			
C.			
M. Miss	4341	2809	
M.			
K.			
Mz.			
Me.			
V.			
S.			
S.			
A			
R.			
P€.			
G.			
T.D.	4351		


Loc. in Sec. NE NE NW

Geol.

Contr. Co. tools

Lse.

Pool Grabs

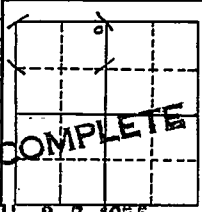

JUL 27 1955

Co. No. Sec. T. R.

Date Comm. 5-23-55

8" @ 216 DST 4343-51 open 2 hr.

Rec. 295' o & Ocm 10' muddywtr.

1260/20" 5½" @ 4351 30/ 4344-49

250 A frac F/ 11 boph 15 hr.

F/ 43 bo 12 hr. Comp. F. 354 bopd 2%wtr.