

Harper
Sec. 36 Twp. 31s Range 9W

#1 Warren

Kansas Geological Society

O. H. Parker
Skelly Scout Tickets

Harper

KANSAS

SEC.	TWP.	R.
36	31S	9W

WELL NO.

1 Warren

FARM

COMPANY

O. H. Barker

CONTRACTOR


Grabs Pool

_____ Ft. from N. Line

_____ Ft. from S. Line

_____ Ft. from E. Line

_____ Ft. from W. Line

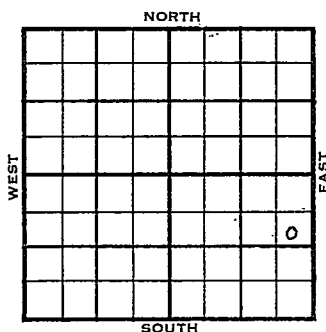

SE NE SE

	ELEVATION	REPORT
1955	1530'	

5/25

H eeb 3371; Doug 3508; Miss 4370;
 TD 4405; 8" 284;
 DST 4381-86 open 1 hr, 2000' gip
 rec 550' ho and gcm, 685' sw;
 DST 4397-4405 open 1 hr 2200' gas,
 rec 150' gcwm, 560' sw, 1665#;
 no log
 D&A

FIRST REPORT

ABANDONED