


Barber

KANSAS

SECTION 36 TOWNSHIP 31 RANGE 10W


WELL NO. #1 Best "B"

COMPANY Petroleum Inc.

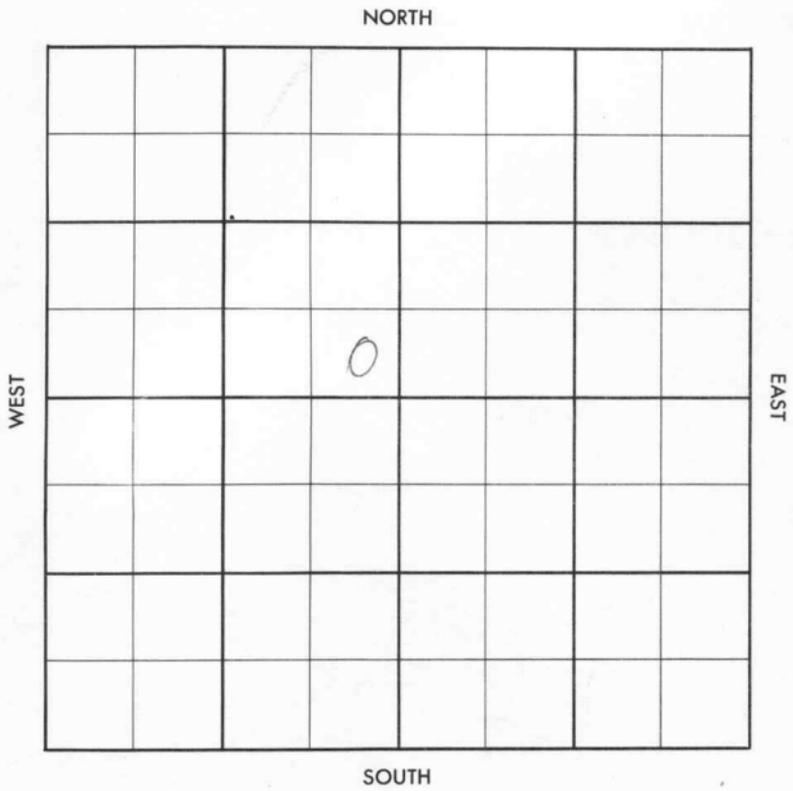

County Barber Elev. _____
 Sec. 36 Twp. 31 Rge. LOW
 Company Petroleum Inc.
 Farm Name Best "B" No. 1

TOPS	DEPTH	LOG	DATUM	Loc. in Sec. _____
Anb.				SE SE NW
Tr.				
H.				
Tr.				
Dg.				
Bl.				
L.				Geol. _____
K.C.				Contr. _____
B.K.C.				
Ce.				Garvey Tools
C.				
M.				Pool
M.				Wildcat
K.				
Mz.				
Me.				
V.				
S.				
S.				
A				
R.				
Pe.				
G.				
T.D.				

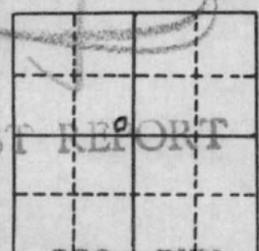

Date Comm. 10-7-56 Magnolia (DHM)
8" @ 229 w/ 150, Drlg. 1100 OCT 10 '56

OCT 10 1956

Handwritten signature

D.M.

Co.
No.
Sec.
T.
R.

County Barber Elev. 1641
 Sec. 36 Twp. 31 Rge. 10W
 Company Petroleum Inc.
 Farm Name Best "B" No. 1

TOPS	DEPTH	LOG	DATUM	Loc. in Sec.
Anh.				SE SE NW
Tp.				
H.	3609			
Tr.	3648			
Dg.	3683			
Bl.				
L.	3769			
K.C.	4046			Geol.
B.K.C.	4278			Contr.
Ce.				Garvey Tool
C.				
M.	4474			Pool
M.				Wildcat
K.				
Mz.				
Me.				
V.				
S.				
S.				
A.				
R.				
Pe.				
G.				
TD	4580			ABANDONED

OCT 24 '56
 CSO DHM
 Magnolia (DHM)

Date Comm. 10-7-56

8" @ 229 w/ 150, Drlg. 1100 OCT 17 '56

405-D OCT 24 '56

DEA