

KANSAS

Stevens

FORM 51 IOM 12-46 PETROL


Section 36 Township 31 Range 37-WWell No. 1 BlackmerCompany Republic Natural Gas

Hugoton Pool

NORTH

WEST

EAST

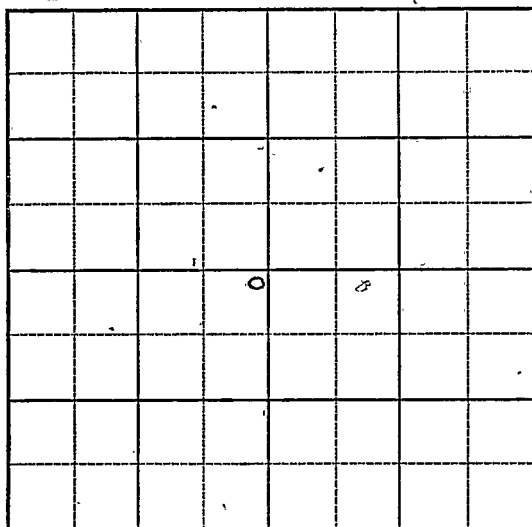

SOUTH

Stevens

Sec. 36 KANSAS Twp. 31 R. 37-W

Well No. 1 Blackmer Farm
Republic Natural Gas Company

Hugoton Pool


100 Ft. from N. Line

 Ft. from S. Line

100 Ft. from E. Line

 Ft. from W. Line

NE SW

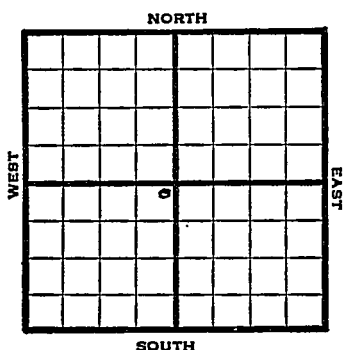

1947 Elev. 3116 REPORT

8/13	10" @ 605'
	Drlg. 1930'
8/20	TD 2610'
	7" @ 2599'
8/27	"
9/3	"
9/10	"
9/17	Fishing 2710'
9/24	Drlg. 2765'
10/1	TD 2810'
	224' of 5" Perf liner @ 2810'
	500 acid
10/8	"
10/15	"
10/22	18560 acid

OVER

1947

11/5 7" @ 2599'
224' of 5" Perf Liner @ 2810'
Acid 24,000
Gas 20,840,000
Rock Pressure 419#
Total Depth 2810'

COMPLETED

Map No. _____ Sec. 36 Twp. 31 R. 37W

Well No. 1 Blackmer

Republic Natural Gas Company

FIRST REPORT

Contractor

NE SW

SECTION PLAT

100 Ft. from N. Line

_____ Ft. from S. Line

100 Ft. from E. Line

_____ Ft. from W. Line

Stevens County

Location _____

Rig up _____

Drilling and Remarks:

10" @ 605

drlg. 1930

RECORD

Cased _____ in. _____ ft.

Sand _____

Gas _____

Oil _____

Total Depth _____

PRODUCTION

1st 24 hrs. Nat. _____

1st 24 hrs. after shot _____

Gas _____ Cu. Ft.

Dry Hole _____

Abandoned _____

Date

AUG 13 1947 19

S. J. LEWIS Scout

Misc. Small Maps

Cards

Tracing

France Map

Scarborough Map

Pierce Map

Geological Dept.

Pierce Plat Book

Map No. _____ Sec. 36 Twp. 31 R. 37W

Well No. 1 Blackmer

Republic Natural Gas Company

COMPLETE

Contractor

NE SW

E 1,3116

SECTION PLAT

100


Ft. from N. Line

Ft. from S. Line

100

Ft. from E. Line

Ft. from W. Line

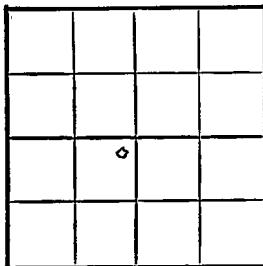

Stevens County

RECORD

Location _____

Cased _____ in., _____ ft.

Rig up _____

Sand _____

Drilling and Remarks:

Gas _____

7" @ 2599

Oil _____

224' of 5" Prof. line

Total Depth 2870

@ 2870

24000000 cu. ft.

PRODUCTION

20,840,000 Gas

1st 24 hrs. Nat. _____

1st 24 hrs. after shot _____

Gas _____ Cu. Ft.

Dry Hole _____

Abandoned _____


419 R.P.

Date

NOV 5 1947 19

S. J. LEWIS

Scout

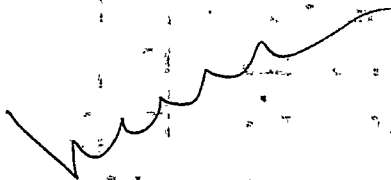

Misc. Small Maps	✓
Cards	✓
Tracing	✓
France Map	✓
Scarborough Map	✓
Mexico Map	✓
Geological Dept.	
Map Flat Box	