

KANSAS

FORM 51 IOM 12-46 PETROL

Comanche County

Section 36 Township 31 Range 20W

Well No. 1 Lorimer


Company Gulf

Wildcat

NORTH

WEST

EAST

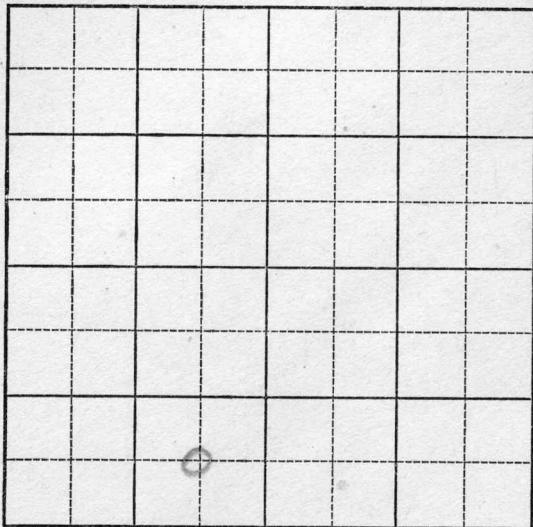

SOUTH

Sec. 36 Twp. KANSAS 31 R. 20-W

Well No. #1 Lorimer Farm

Gulf Company

Wildcat

Ft. from N. Line

660


Ft. from S. Line

660

Ft. from E. Line

Ft. from W. Line

C SE SW

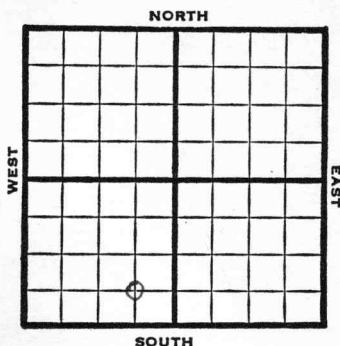

1947

Elev. 2105'

REPORT

7/2 Location

7/8 "

7/16 13" @ 222'
WOC

7/22 8" @ 2450
WOC

7/29 Drlg 3920'

8/6 Herington 2482'
Ft. Kiley 2664'
Heeover (?) 4067'
Douglas shale 4138'
Drlg 4890'

8/13 Lansing 4276'
KC 4826
Mississippi 5191
Drlg. 5245'

8/20 Drlg 5755'

8/27 Viola 5988'
Drlg. 6041'

9/3 Simpson 146'
Arbuckle 6306'
TD 6365'

OVER

1947

9/10 5" @ 5194'
RUST

9/17 "

9/24 "

10/1 PB 5290'
2000 acid swb $7\frac{1}{2}$ bbls oil
PH 4 hrs - 6000 acid

10/8 Pump 3- $\frac{1}{4}$ bbls water PH,
18 hrs PB

10/15 PB 5230' swb water

10/22 18 shots 5191-94 2000 acid swb
188 bbls water in 14 hrs, trace oil

10/29 Pump 87 bbls W in 7 hrs
SS Gas

11/5 Pump 2 $\frac{1}{2}$ bbls oil & 27 $\frac{1}{2}$ W
24 hrs.

11/12 Pump 2 $\frac{1}{2}$ bbls. oil / 27 W in 24 hrs.

11/19 Pump 4 bbls oil & 15 W a day

11/25 "

12/3 "

12/10 "

12/17 "

12/30 "

1948

1/7 "

1/14 PB 5259-85'
85 shots 2507-37'
Swb 3 bbls oil / 56 $\frac{1}{2}$ W 24 hrs

1/21 Arb. 6306'
5" @ 5194'
TD 6365'
Abd.

ABANDONED

Map No. _____ Sec. 36 Twp. 31 R. 20W

Well No. 1 Lorimer

Gulf Company

FIRST REPORT

Contractor _____

C SE SW

SECTION PLAT

_____ Ft. from N. Line

660 Ft. from S. Line

660 Ft. from E. Line

_____ Ft. from W. Line

Comanche County

Location X

Rig up _____

Drilling and Remarks:

RECORD

Cased _____ in., _____ ft.

Sand _____

Gas _____

Oil _____

Total Depth _____

PRODUCTION

1st 24 hrs. Nat. _____

1st 24 hrs. after shot _____

Gas _____ Cu. Ft.

Dry Hole _____

Abandoned _____

Date

JUL 2 1947 19 _____ S. J. LEWIS Scout


Map No. 95 Sec. 36 Twp. 31 R. 20WWell No. 1 LorimorGulf

Company

ABANDONED

Contractor

C SE SW

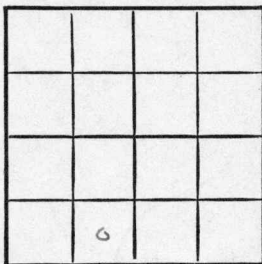E1.2104
SECTION PLAT Ft. from N. Line660 Ft. from S. Line660 Ft. from E. Line Ft. from W. Line

Comanche County

Location Rig up

Drilling and Remarks:

CE 63065' 205194

RECORD

Cased in., ft.Sand Gas Oil Total Depth 6365

PRODUCTION

1st 24 hrs. Nat. 1st 24 hrs. after shot Gas Cu. Ft.Dry Hole Abandoned

Date

JAN 21 1948

19

S. J. LEWIS

Scout


Map No. _____

Well No. _____

Company _____

Contractor _____

SECTION PLAT

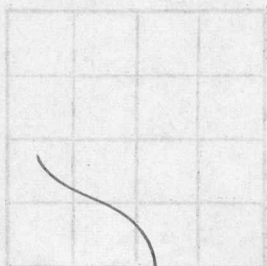

1/4 from N. line

1/4 from E. line

1/4 from S. line

1/4 from W. line

RECORD

Cased _____

Shale _____

Gas _____

Oil _____

Total Depth _____

PRODUCTION

Misc. Small Maps _____

Cards _____

Tracing _____

France Map _____

Scarborough Map _____

Pierce Map _____

Geological Dept. _____

Pierce Plat Book _____

Location _____

Rig up _____

Drilling and Cementing _____

Date _____