


Section 36 Township 31 Range 2-W

Well No. #1, Brandenburg

Company Geo. Johnston

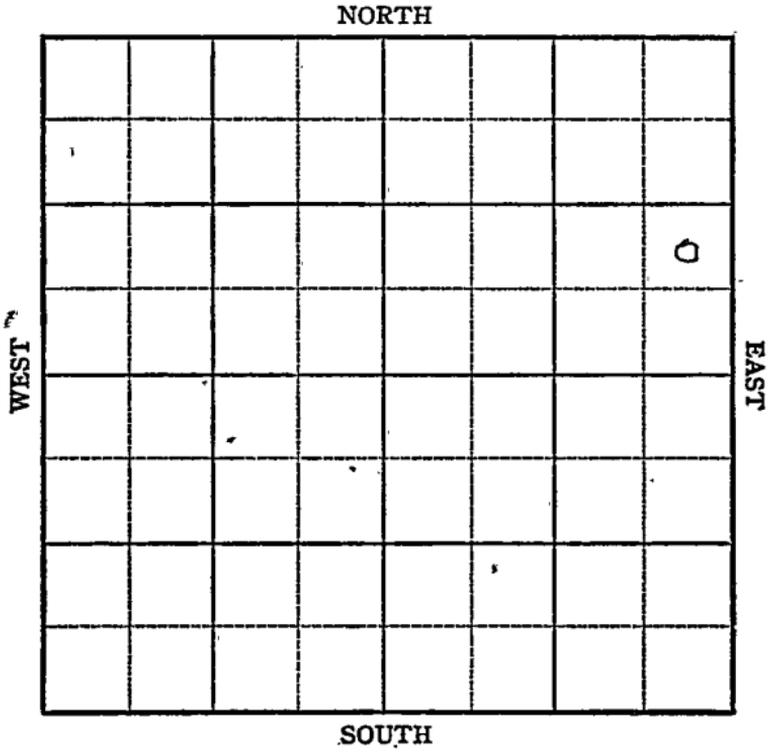

Sec. 36 Twp. 31 R. 2W

Well No. 1 Brandenburg Farm

Geo. Johnston Company


Miscellaneous

Ft. from N. Line

990 Ft. from S. Line

330 Ft. from E. Line

Ft. from W. Line

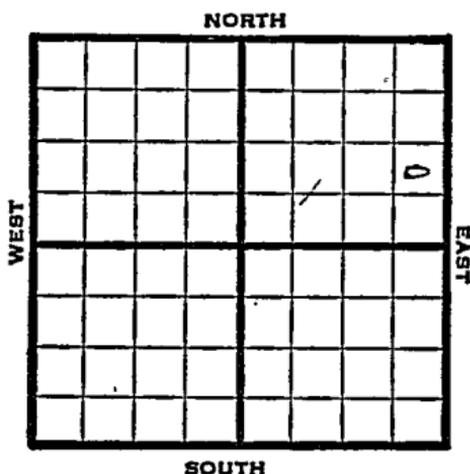

NE SE NE

1947

1250 REPORT

1/8 Location

1/15 "

1/21 ROR

2/12 KC 3110  
Miss 3750  
TD 3788'

ABANDONED

Map No. 31 Sec. 36 Twp. 31 R. 2W

Well No. 1 B Bandenberg

Geo. Johnston \_\_\_\_\_ Company

**FIRST REPORT** \_\_\_\_\_ Contractor

NE SE NE

**SECTION PLAT**

			o

\_\_\_\_\_ Ft. from N. Line

990 Ft. from S. Line

330 Ft. from E. Line

\_\_\_\_\_ Ft. from W. Line

Sumner County

Location X

Rig up \_\_\_\_\_

Drilling and Remarks:

**RECORD**

Cased \_\_\_\_\_ in., \_\_\_\_\_ ft.

Sand \_\_\_\_\_

Gas \_\_\_\_\_

Oil \_\_\_\_\_

Total Depth \_\_\_\_\_

**PRODUCTION**

1st 24 hrs. Nat. \_\_\_\_\_

1st 24 hrs. after shot \_\_\_\_\_

Gas \_\_\_\_\_ Cu. Ft.

Dry Hole \_\_\_\_\_

Abandoned \_\_\_\_\_

Date

JAN 8 1947 19

S. J. LEWIS Scout

Map No. 31 Sec. 36 Twp. 31 R. 2W

Well No. 1 Brandenburg

Geo. Johnston Company

**ABANDONED** Contractor

NE SE NE

**SECTION PLAT**

			o

\_\_\_\_\_ Ft. from N. Line

990 Ft. from S. Line

330 Ft. from E. Line

\_\_\_\_\_ Ft. from W. Line

Sumner County

**RECORD**

Location \_\_\_\_\_

Cased \_\_\_\_\_ in., \_\_\_\_\_ ft.

Rig up \_\_\_\_\_

Sand \_\_\_\_\_

Drilling and Remarks:

Gas 1200

Oil \_\_\_\_\_

Total Depth 3288

*KC3110*  
*Miss 3758*

**PRODUCTION**

1st 24 hrs. Nat. \_\_\_\_\_

1st 24 hrs. after shot \_\_\_\_\_

Gas \_\_\_\_\_ Cu. Ft.

Dry Hole \_\_\_\_\_

Abandoned \_\_\_\_\_

Date

FEB 12 1947 19

S. J. LEWIS Scout