

Stevens

Section 10 Township 31 Range 39W


Well No. #1-10 Pettijohn

Company Hugoton Prod.

NORTH

WEST

EAST

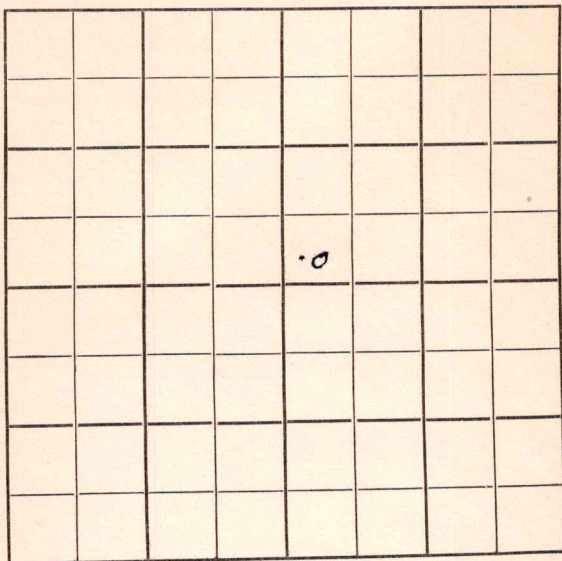

SOUTH

Stevens

KANSAS

Sec. 10 Twp. 31 R. 39W

Well No. #1-10 Pettijohn Farm

Hugoton Prod.

Company

Hugoton Pool

Contractor


2451' Ft. from N. Line

Ft. from S. Line

2234' Ft. from E. Line

Ft. from W. Line

SW NE of the section

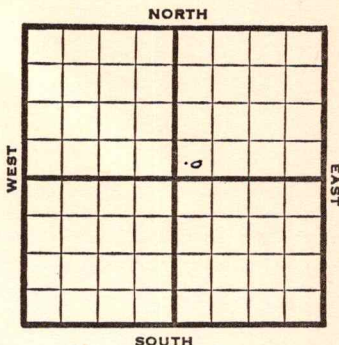

1950

Elev 3189

REPORT

3/29 Location

5/31 10" @ 603

7" @ 2383

TD 2665

2000A

Hev 2403

Krider 2435

Win 2507

Ft. Riley 2572

comp 18,425,000 gas open flow

COMPLETED

Kansas

Map No. _____ Sec. 10 Twp. 31 R. 39WWell No. 1-10 Pettijohn

_____ Hugoton Prod. _____ Company

_____ Contractor

SWNE

SECTION PLAT

2451 Ft. from N. Line

_____ Ft. from S. Line

2234 Ft. from E. Line_____ Ft. from W. Line
of the Section

Stevens County

Location X

Rig up _____

Drilling and Remarks:

RECORD

Cased _____ in., _____ ft.

Sand _____

Gas _____

Oil _____

Total Depth _____

PRODUCTION

1st 24 hrs. Nat. _____

1st 24 hrs. after shot _____

Gas _____ Cu. Ft.

Dry Hole _____

Abandoned _____

Date

MAR 29 1950

19

J. E. TYRA

Scout

Map No. _____ Sec. 10 Twp. 31 R. 39WWell No. 1-10 PettijohnHugoton Prod. _____ Company

_____ Contractor

SW NE

E1.3189


SECTION PLAT

2451 Ft. from N. Line

_____ Ft. from S. Line

2234 Ft. from E. Line

_____ Ft. from W. Line

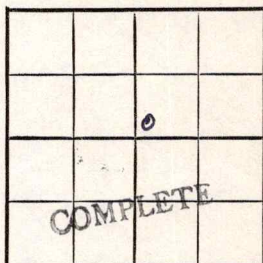Stevens

Location _____

Rig up _____

Drilling and Remarks:

10" C 603
7" C 2383
T.D. 2665
2000 A
Nev. 2403
Kriden 2435
Wiw. 2507
7+Riley 2572

Date

RECORD

Cased _____ in., _____ ft.

Sand _____

Gas _____

Oil _____

Total Depth 2665

PRODUCTION

1st 24 hrs. Nat. _____

1st 24 hrs. after shot _____

Gas _____ Cu. Ft.

Dry Hole _____

Abandoned _____

Comp. 18, 425,000 gas open flow
Date

MAY 31 1950

19

J. E. TYRA Scout