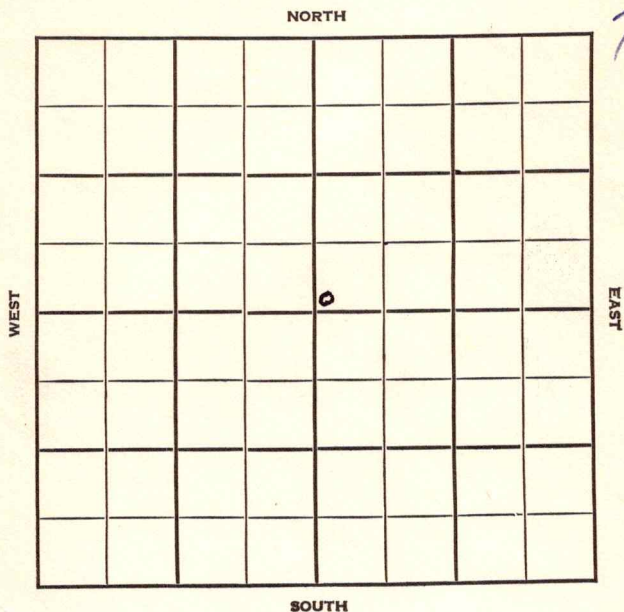


KANSAS

Morton

Section 29 Township 31 Range ~~39W~~Well No. #1 First State Bank of LarnedCompany Stanolind

Sec. 29 Twp. 31 R. 39W

Well No. #1 First State Bank of Iarned Farm

Stanolind Company
Hugoton


 Ft. from N. Line

150 Ft. from S. Line

 Ft. from E. Line

150 Ft. from W. Line

SW NE

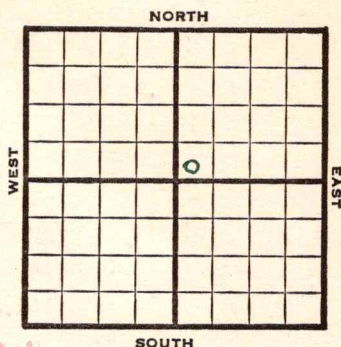

1948

^Elev. 3245' REPORT

1/14	Location
1/21	"
1/26	"
2/4	10" @ 565' Drlg. 2215'
2/11	TD 2390' 7" @ 2385' BUST
2/18	rlg 2410'
2/25	TD 2605' 18,000 acid.
3/3	"
3/10	"
3/17	"
3/24	"
3/31	"
4/7	"
4/14	"
4/21	"
4/28	"
5/5	"

OVER

1948

5/12

7" @ 2385'

23' of 5" perf. liner @ 2605'

18,000 acid

5,930,000 gas.

410# R. Pr.

TD 2605'

Comp.

COMPLETED

Map No. _____ Sec. 29 Twp. 31 R. 39W

Well No. 1 First State Bank of Larned

Stanolind Company

FIRST REPORT

Contractor _____

SW NE

SECTION PLAT

_____ Ft. from N. Line

150 Ft. from S. Line

_____ Ft. from E. Line

150 Ft. from W. Line

		D	

Morton County

Location X

Rig up _____

Drilling and Remarks:

RECORD

Cased _____ in., _____ ft.

Sand _____

Gas _____

Oil _____

Total Depth _____

PRODUCTION

1st 24 hrs. Nat. _____

1st 24 hrs. after shot _____

Gas _____ Cu. Ft.

Dry Hole _____

Abandoned _____

Date

JAN 14 1948

19

S. J. LEWIS

Scout

Map No. _____ Sec. 29 Twp. 31 R. 39W

Well No. 1 First State Bank 6f Larned

Stanolind

Company

COMPLETE

Contractor

SW NE

B1, 32 & 35

SECTION PLAT

_____ Ft. from N. Line

150 Ft. from S. Line

_____ Ft. from E. Line

150 Ft. from W. Line

Morton County

Location _____

Rig up _____

Drilling and Remarks:

7" C 2385

28' of 5" Pay liner

C 2605

18000 cu. ft.

5, 980, 000 Gas

410 # RA

RECORD

Cased _____ in., _____ ft.

Sand _____

Gas _____

Oil _____

Total Depth 2605

PRODUCTION

1st 24 hrs. Nat. _____

1st 24 hrs. after shot _____

Gas _____ Cu. Ft.

Dry Hole _____

Abandoned _____

Date

MAY 12 1948

19

S. J. LEWIS

Scout