FORM 51 25M 3-49 PETROL Stevens


NSAS

Section 34 Township 31 Range 39W

Well No. #1 Close

Company Houghton Prod.

14/

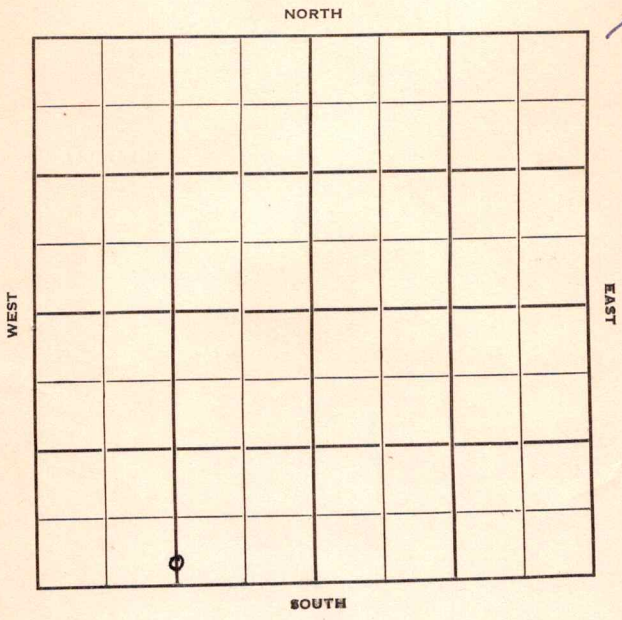

FORM 252-B
10M 9-49 PETROL

KANSAS

Stevens

Sec. 34 Twp. 31 R. 39-W

Well No #1 Close Farm

Houghton Prod Company

Contractor

Hugoton


_____ Ft. from N. Line

200 Ft. from S. Line

_____ Ft. from E. Line

1320 Ft. from W. Line

C S L SW/4

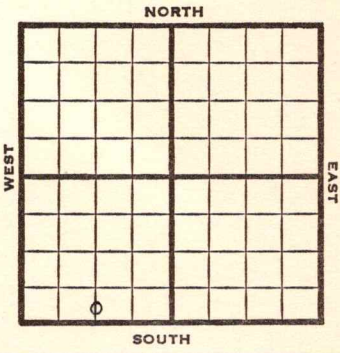

1950	Elev 3227 REPORT
7/26	Location
10/18	Spud 8-25-50 10" @ 590 7" @ 2391 TD 2643 283' of 5" liner 11000 total aicd Hol 2355 Her 2389 Krider 2412-69 Win 2481-2518 Towanda 2551-86 Ft. Riley 2602 Comp 19,942,000 gas open flow Completed COMPLETED

Form 26 200 Bks. 11-49 Petrol

Hugoton Pool

Kansas

Map No. _____ Sec. 34 Twp. 31 R. 39W

Well No. 1 Close

Houghton Prod. Company

Contractor

C S L SW/4

SECTION PLAT



_____ Ft. from N. Line

200 Ft. from S. Line

_____ Ft. from E. Line

1320 Ft. from W. Line

Stevens County

Location x

Rig up

Drilling and Remarks:

RECORD

Cased _____ in., _____ ft.

Sand

Gas

Oil

Total Depth

PRODUCTION

1st 24 hrs. Nat.

1st 24 hrs. after shot

Gas _____ Cu. Ft.

Dry Hole

Abandoned

Date

JUL 26 1950 19

J. E. TYRA Scout

FORM 275 FOR SALE BY KANSAS BLUE PRINT CO.


County Stevens State Kansas

Sec. 34 (Blk. Twp.) 31 (Sur. Rge.) 39W Map No.

Operator Hugoton Prod.

Well No. 1 Farm Close

Elev. 3227 Location C S L SW/4

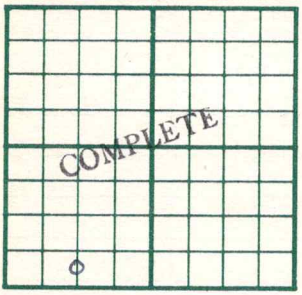

200 Ft. From S Line SW

1320 Ft. From W Line Quarter

1st. Report

Completion OCT 1 8 1950

Remarks Hugoton Pool

Spudding Date 8-25-50

Drlg. Data Gas well TD 2643

10" @ 590 7" @ 2391 TD 2643

283' of 5" liner 11000 total acid

Hol. 2355 Her. 2389 Krider 2412-69

Win. 2481-2518 Towanda 2551-86

Ft. Riley 2602 Comp. 19,942,000 gas
open flow

J. E. TYRA