

# STATE CORPORATION COMMISSION OF KANSAS OIL & GAS CONSERVATION DIVISION

## WELL COMPLETION OR RECOMPLETION FORM ACO-1 WELL HISTORY

### DESCRIPTION OF WELL AND LEASE

Operator: license # 5146  
name Rains & Williamson Oil Co., Inc.  
address 435 Page Court,  
220 West Douglas  
City/State/Zip Wichita, Kansas 67202

Operator Contact Person Juanita Green  
Phone (316) 265-9686

Contractor: license # 5146  
name Rains & Williamson Oil Co., Inc.

Wellsite Geologist Mike D. Engelbrecht  
Phone (316) 265-9686

PURCHASER CLEAR CREEK

### Designate Type of Completion

☒ New Well ☐ Re-Entry ☐ Workover

☒ Oil ☐ SWD ☐ Temp Abd  
☐ Gas ☐ Inj ☐ Delayed Comp.  
☐ Other (Core, Water Supply etc.)

### If OWWO: old well info as follows:

Operator  
Well Name  
Comp. Date Old Total Depth

### WELL HISTORY

Drilling Method: ☒ Mud Rotary ☐ Air Rotary ☐ Cable

4-9-86 4-23-86 5-18-86  
Spud Date Date Reached TD Completion Date

4466' Total Depth PBTB

Amount of Surface Pipe Set and Cemented at 292' feet

Multiple Stage Cementing Collar Used? ☐ Yes ☐ No

If Yes, Show Depth Set feet

If alternate 2 completion, cement circulated  
from feet depth to w/ SX cmt

API NO. 15 191-21,927

County Sumner

SW SW NE Sec. 25 Twp. 31S Rge. 4

2970 Ft North from Southeast Corner of Sect

2310 Ft West from Southeast Corner of Sect

(Note: locate well in section plat below)


Lease Name KRAUS Well# 1

Field Name Wildcat

Producing Formation Kansas City

Elevation: Ground 1326 KB 1335

Section Plat

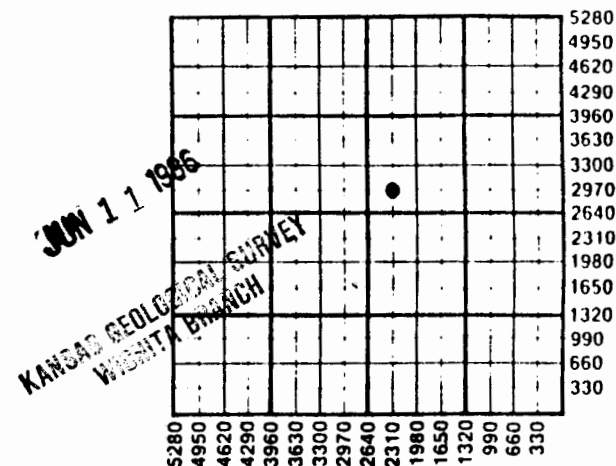

### WATER SUPPLY INFORMATION

Source of Water:

Division of Water Resources Permit #

☐ Groundwater. Ft North From Southeast Corner of (Well) Ft West From Southeast Corner Sec Twp Rge ☐ East ☐ West

☐ Surface Water. Ft North From Southeast Corner of (Stream, Pond etc.) Ft West From Southeast Corner Sec Twp Rge ☐ East ☐ West

☐ Other (explain) (purchased from city, R.W.D.#)

Disposition of Produced Water: ☐ Disposal ☐ Repressuring

Docket #

**INSTRUCTIONS:** This form shall be completed in duplicate and filed with the Kansas Corporation Commission, 200 Colorado Derby Building, Wichita, Kansas 67202, within 90 days after completion or recompletion of any well. Rules 82-3-130 and 82-3-107 apply.

Information on side two of this form will be held confidential for a period of 12 months if requested in writing and submitted with the form. See rule 82-3-10 for confidentiality in excess of 12 months.

1 Ped +  
**RELEASED**

AUG 1 1987

KCC

Date: \_\_\_\_\_

DRILLER'S LOG

FROM CONFIDENTIAL

COMPANY: Rains & Williamson Oil Co., Inc.

SEC. 25 T. 31S R. 4W

WELL NAME: KRAUS #1

LOC. SW SW NE

COUNTY: Sumner

RIG NO. #3

**CONFIDENTIAL**

TOTAL DEPTH 4466'

ELEVATION 1326 GL 1335 KB

COMMENCED: 4-9-86

COMPLETED: 4-23-86

CONTRACTOR: Rains & Williamson Oil Co., Inc.

CASING RECORD:

SURFACE: 8 5/8" @ 292' w/200 sx. 60-40 poz., 3% cc.

PRODUCTION: 5 1/2" @ 3595' w/100 sx. 60-40 poz. salt saturated, 6#  
gilsonite per sx., 3/4 of 1% CFR-T 300 gallons flowcheck  
flushed ahead LOG of cement.

(Figures Indicate Bottom of Formations)

|                           |             |
|---------------------------|-------------|
| Shale & Lime              | 1260        |
| Shale                     | 1343        |
| Shale & Lime              | 1850        |
| Lime & Shale              | 2261        |
| Shale & Lime              | 2455        |
| Lime & Shale              | 2814        |
| Shale & Lime              | 2985        |
| Lime & Shale              | 4466        |
| <u>ROTARY TOTAL DEPTH</u> | <u>4466</u> |

MAY 07 1986  
KANSAS GEOLOGICAL SURVEY  
WICHITA BRANCH

RECEIVED  
STATE CORPORATION COMMISSION

MAY 07 1986

CONSERVATION DIVISION  
Wichita, Kansas

AUG 17 1987  
KANSAS GEOLOGICAL SURVEY  
WICHITA BRANCH

STATE OF KANSAS )  
COUNTY OF SEDGWICK )

SS: