7-31-4W

WELL LOG BUREAU--KANSAS GEOLOGICAL SOCIETY
508 East Murdock, Wichita, Kansas


Company. WALTER W. CLEMENTS, JR.
Farm. Myers No. 1

SEC. 7 T. 31 R. 4W
SE SE SW

Total Depth. 4615'
Comm. 12-22-60 Comp. 1-20-61
Shot or Treated.
Contractor. Fortune Oil & Gas
Issued. 12-16-61

CASING:
8 5/8" 258' cem w/200 sx.

County Sumner
KANSAS

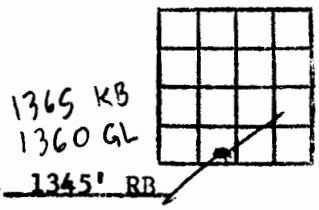

Elevation. 1345' RB

Production. Dry

Figures Indicate Bottom of Formations.

soil, red bed	100
shale, lime	258
shale	755
shale, lime	1495
lime	1850
shale, lime	2549
lime	2618
lime, shale	2709
lime	2757
sand	2816
shale, lime	3226
sand, shale	3321
lime	3403
shale, lime	3495
lime (KC)	3836
shale, lime	4158
chat, lime (Miss.)	4227
lime	4522
lime, shale	4578
shale, sand (Simp.)	4591
sand	4615
Total Depth	

TOPS: SCOUT	
Kansas City	3501
Mississippi	4159
Kinderhook	4495
Simpson Shale	4573
Simpson Sand	4589