

Barber


FORM-51 IOM 12-46 PETROL

KANSAS

Section 4 Township 31 Range 14W

Well No. 1 Hargis "C"

Company Stanolind

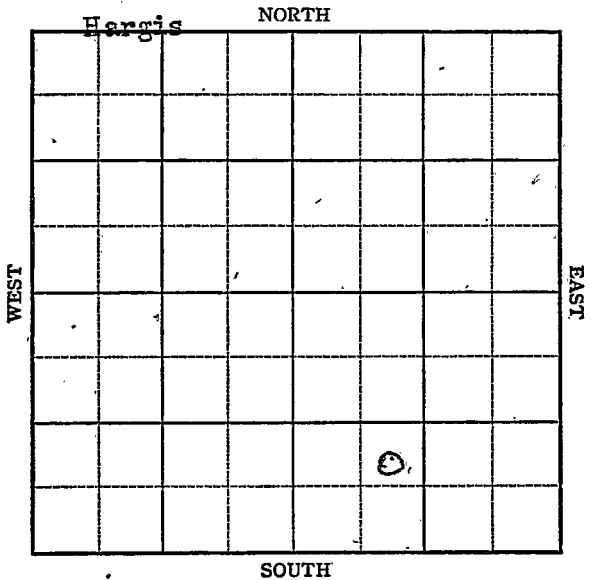

KANSAS

Sec. 4 Twp. 31 R. 14-W X

Well No. #1 Hargis "C" Farm

Stanolind

Company


Hargis Pool

Ft. from N. Line

990 Ft. from S. Line

Ft. from E. Line

990 Ft. from W. Line

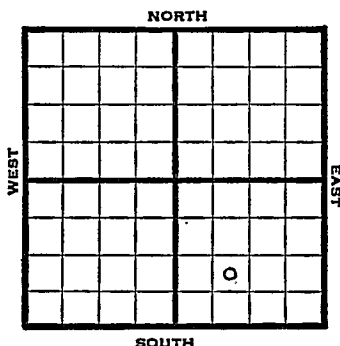

NE SW SE

1947 Elev. REPORT 1717'

6/18 Location

6/24 RUR

7/1 "

7/8 13" @ 203'
WOC

7/16 Drlg 2467'

7/22 Drlg. 3745'

7/29 Nag. 4399'
Drlg 4427

8/6 Drlg 4460'

8/13 Viola 4455
TD 4460
5" @ 4455
RUST

8/20 "

8/27 Viola 4455'
5" @ 4455'
Wagr 4399'
Perf Wagr
7,000 Acid
15,638,000 Gas
Total Depth 4460'

COMPLETED

Map No. _____ Sec. 4 Twp. 31 R. 14W

Well No. 1 Hargis "C"

Stanolind Company

FIRST REPORT Contractor

NE SW SE


SECTION PLAT

_____ Ft. from N. Line

990 Ft. from S. Line

_____ Ft. from E. Line

990 Ft. from W. Line

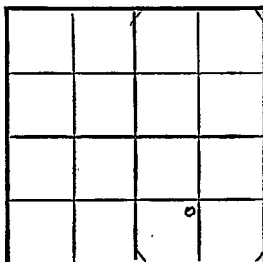

Barber County

Location X

Rig up _____

Drilling and Remarks:

RECORD

Cased _____ in, _____ ft.

Sand _____

Gas _____

Oil _____

Total Depth _____

PRODUCTION

1st 24 hrs. Nat. _____

1st 24 hrs. after shot _____

Gas _____ Cu. Ft.

Dry Hole _____

Abandoned _____

Date

JUN 1 8 1947

19

S. J. LEWIS Scout

Map No. 93 Sec. 4 Twp. 31 R. 14W

Well No. 1 Hargis "C"

StanoIind Company

COMPLETE Contractor

NE SW SE

E11717
SECTION PLAT

 Ft. from N. Line

990 Ft. from S. Line

 Ft. from E. Line

990 Ft. from W. Line

Barber County

Location

Rig up

Drilling and Remarks:

Vista 4455

5" @ 4455

Magv 4399

Perf Magv
20000 cu ft

15,638,000 Gas

RECORD

Cased in., ft.

Sand

Gas

Oil

Total Depth 4460

PRODUCTION

1st 24 hrs. Nat.

1st 24 hrs. after shot

Gas Cu. Ft.

Dry Hole

Abandoned

Date

AUG 27 1947

19

S. J. LEWIS

Scout