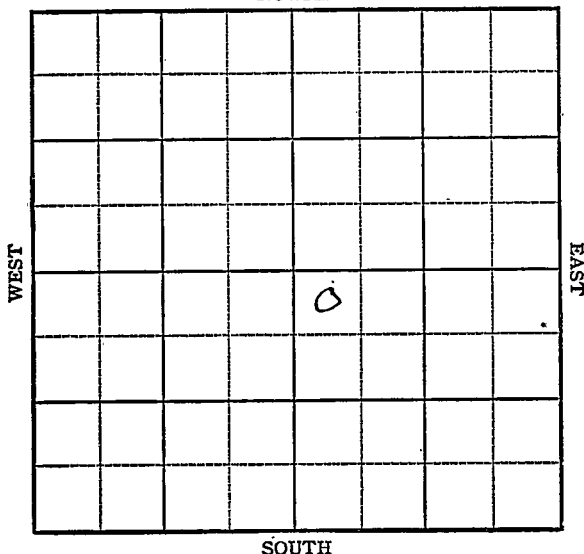


Section 4 Township 31 Range 35WWell No. 1 O'BeaCompany MagnoliaHugoton Pool
NORTH

KANSAS Stevens ✓

Sec. 4 Twp. 31 R. 35W

Well No. 1 O'Bea Farm

Magnolia Company

Hugoton Pool


330 Ft. from N. Line

 Ft. from S. Line

 Ft. from E. Line

330 Ft. from W. Line

NW SE

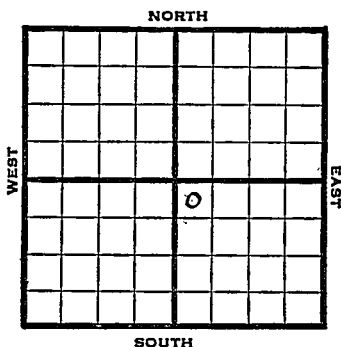

1948 Elev. 2946' REPORT

9/1 10" @ 603'
Drlg 650'

9/8 Drlg. 2755'

9/14 7" @ 2756
TD 2760'
192 shots 2660-2700 - 7000 Acid
96 " 2613-31 - " "n
144 " 2564-94 - " "

9/21 "

9/29 "

10/6 7" @ 2756'
Perf
Acid 21,000
Gas 16,300,000
R. Pr. 419#
TD 2760'

COMPLETED


Stevens County Kansas StateMap No. _____ Sec. 4 Twp. 31 R. 35WWell No. 1 O'BeaMagnolia Company

FIRST REPORT

Contractor

NW SE

SECTION PLAT

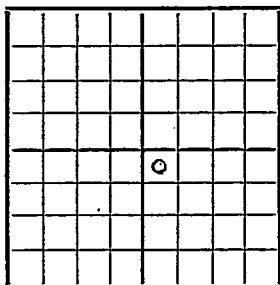330 Ft. from N. Line Ft. from S. Line Ft. from E. Line330 Ft. from W. LineHugoton Pool

Remarks:

10" @ 603 drlg. 650

Date

SEP 1 1948

Scout

S. J. LEWIS

Map No. _____ Sec. 4 Twp. 31 R. 35W

Well No. 1 O'Bea Est.

Magnolia Company

COMPLETE

Contractor

NW SE

E 112946
SECTION PLAT

330 Ft. from N. Line

_____ Ft. from S. Line

_____ Ft. from E. Line

330 Ft. from W. Line

		6	

Stevens County

Location _____

Rig up _____

Drilling and Remarks:

7" @ 2756

Perf

210000000

16,300,000 Gas

419* R₂

RECORD

Cased _____ in., _____ ft.

Sand _____

Gas x _____

Oil _____

Total Depth 2760

PRODUCTION

1st 24 hrs. Nat. _____

1st 24 hrs. after shot _____

Gas _____ Cu. Ft.

Dry Hole _____

Abandoned _____

Date

OCT 6 1948

S. J. LEWIS Scout