

KANSAS

FORM 51 IOM 12-46 PETROL

Seward


Section 4 Township 31 Range 34-W

Well No. 1 Etzold

Company R.E. Davis

Hugoton Pool

NORTH

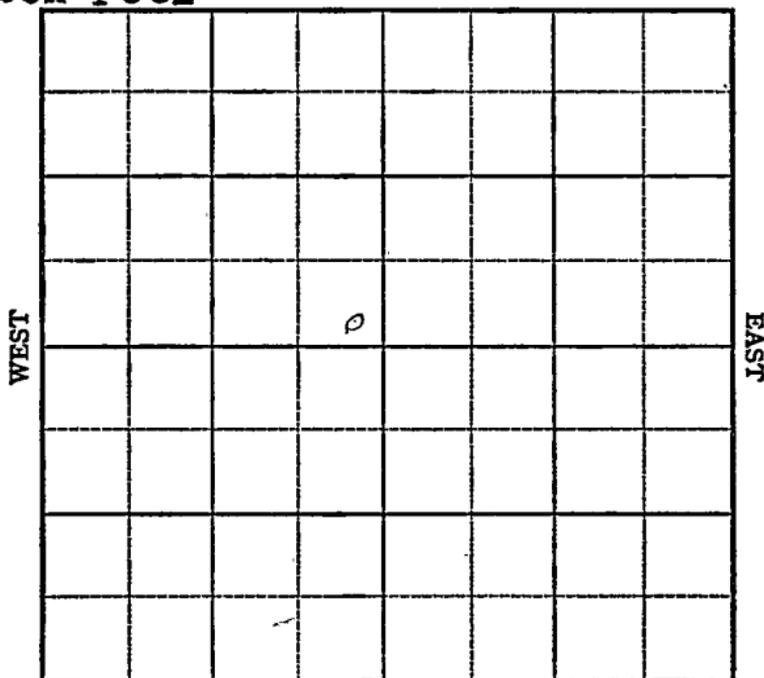

SOUTH

Sec. 4 Twp. 31 R. 34W

Well No. #1 Etzold Farm

R. E. Davis Company

Hugoton


_____ Ft. from N. Line

100 Ft. from S. Line

200 Ft. from E. Line

_____ Ft. from W. Line

SE NW

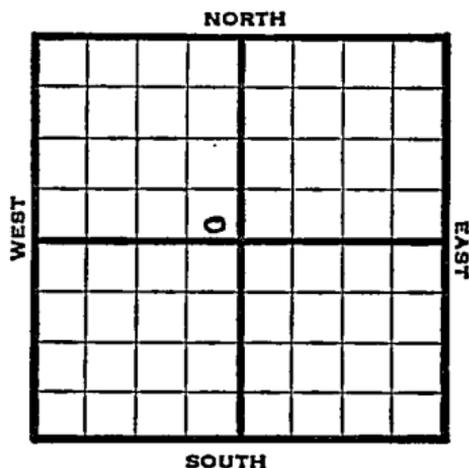

1947

Elev. 2826' REPORT

9/24 10" @ 610'

WOC

10/1 TD 2422'
7" @ 2422'

10/8 TD 2600'

10/15 221' of 5" Perf Liner @ 2600 -
3000 acid

10/22 12000 acid

10/29 7" @ 2422'
221' of 5" perf liner @ 2600
15,000 Acid
11,300,000 Gas
TD 2600
383# RPr

COMPLETED

Map No. _____ Sec. 4 Twp. 31 R. 34W

Well No. 1 Etzold

R. E. Davis Company

FIRST REPORT

Contractor

SE NW


SECTION PLAT

_____ Ft. from N. Line

100 Ft. from S. Line

200 Ft. from E. Line

_____ Ft. from W. Line

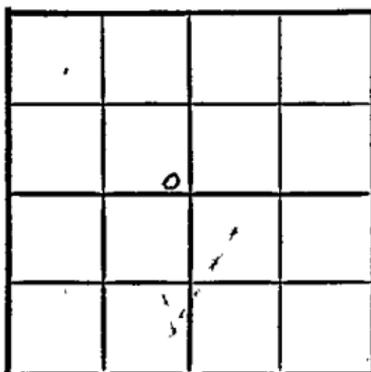

Seward County

Location _____

Rig up _____

Drilling and Remarks:

10" @ 610 WOC

RECORD

Cased _____ in., _____ ft.

Sand _____

Gas _____

Oil _____

Total Depth _____

PRODUCTION

1st 24 hrs. Nat. _____

1st 24 hrs. after shot _____

Gas _____ Cu. Ft.

Dry Hole _____

Abandoned _____

Date

SEP 24 1947 19

S. J. LEWIS Scout

Map No. 0 Sec. 4 Twp. 31 R. 34W

Well No. 1 Etzold

R. E. Davis Company

COMPLETE

Contractor

SE NW

E12826

SECTION PLAT

_____ Ft. from N. Line

100 Ft. from S. Line

200 Ft. from E. Line

_____ Ft. from W. Line

		o	

Seward County

Location _____

Rig up _____

Drilling and Remarks:

7' @ 2422,
22 1/2" 5" Jpg liner
@ 2600
15000 acid
11,300,000 Gas
STB # R 2

RECORD

Cased _____ in., _____ ft.

Sand _____

Gas _____

Oil _____

Total Depth 2600

PRODUCTION

1st 24 hrs. Nat. _____

1st 24 hrs. after shot _____

Gas _____ Cu. Ft.

Dry Hole _____

Abandoned _____

Date

OCT 29 1947

19

S. J. LEWIS

Scout