

Clark


KANSAS

SECTION 4 TOWNSHIP 31 RANGE 21 W

WELL NO. #1 Dailey

COMPANY Stearns Pet. Inc.

NORTH

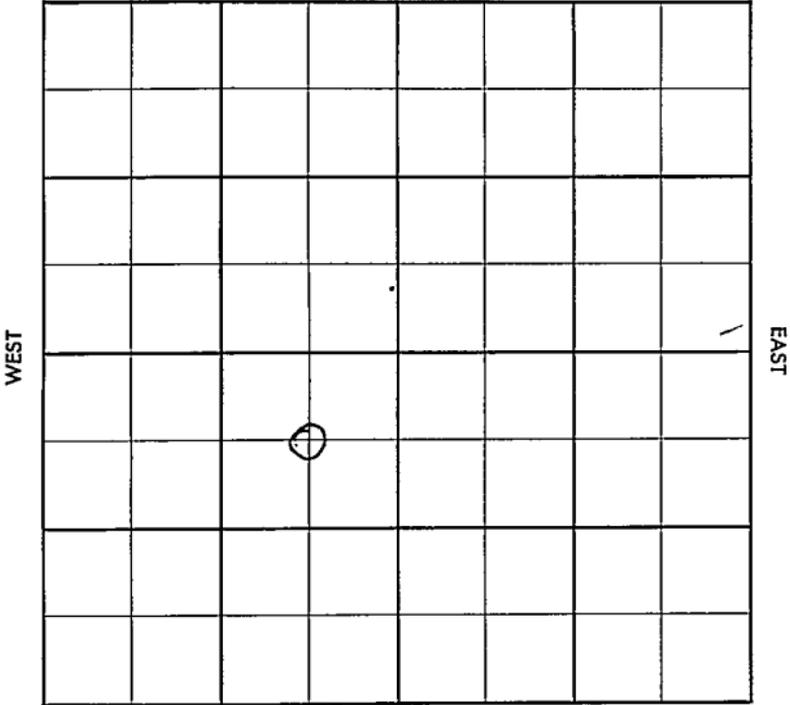

SOUTH

Clark

KANSAS


SEC. 4	TWP. 31	R. 21W
-----------	------------	-----------

WELL NO. #1 Dailey FARM

COMPANY Stearns Pet. Inc.

CONTRACTOR Trans-Era

\_\_\_\_\_ Ft. from N. Line  
 \_\_\_\_\_ Ft. from S. Line  
 \_\_\_\_\_ Ft. from E. Line  
 \_\_\_\_\_ Ft. from W. Line

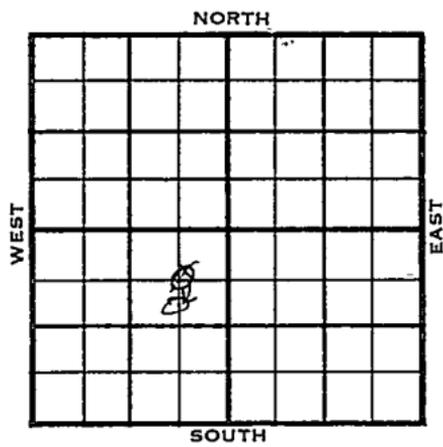

~~C NE SW~~ CS<sup>1/2</sup> NE SW

Northern Nat. FO

	ELEVATION	REPORT
1955	2218 DF, 2223 RB	
11-30	Comm. 11-22-55 20" @ 98/377 Drlg. 3145' BKC 4925	L. 4472
1956	KC 4469	BL 4452
4-25	DST 5110-26 op 1 hr. rec. 135' mud, 170/30" Tr. 4287 DST 5110-26 op 1 hr. rec. 12' mud, 0/30" DST 5180-5204 op 1 hr. rec. 3' mud, 32/60" H. 4270' DST 5206-54 op 2 hrs. rec. 2500' gas, 180' vghocm, 264/30" 5 1/2" @ 5205/125 CO to 5254 B/ 10 go 1 hr. SD 12 hrs., FU 100' oil, PB 5225, SD 12 hrs. FU 600' oil, 500 A, sd 12 hrs. FU 2000' oil, S/ 2 1/2 boph, SD 12 hrs., FU 2000' oil, S/ 3 boph, frac FU 4000' fluid S/ 13 boph P/ 80 bopd, 4 days, P/ 35 bopd. Comp. 35 bopd, 30% wtr. TD 5254' M. 5169 5164 Ce. 5071 5056	

COMPLETED

# CORRECTION

FORM 513 REV. SUNRAY

County Clark Elev. \_\_\_\_\_  
 Sec. 4 Twp. 31 Rge. 21W  
 Company Stearns Pet.  
 Farm Name Dailey No. 1

TOPS	DEPTH	LOG	DATUM	Loc. in Sec.
Anh.				C S $\frac{1}{2}$ NE SW
Tr.				
H.				
Tr.				
Dg.				
Bl.				
L.				
K.C.				Geol. _____
B.K.C.				Contr. _____
Ce.				
C.				
M.				
M.				Pool _____
K.				
Mz.				
Ma.				
V.				
S.				
S.				
A.				
R.				
Pe.				
G.				
T.D.				

CORRECTION

Date Comm. \_\_\_\_\_  
Reported C NE SW

APR 25 1956

Co. No. Lse. No. Sec. T. R.




4 1/2



MAY 4 1956

P. R. G.

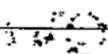

2218 DF

County Clark Elev. 2223 RB

Sec. 4 Twp. 31 Rge. 21W

Company Stearns Pet. Inc.

Farm Name Dailey No. 1

TOPS	DEPTH	LOG	DATUM
------	-------	-----	-------

Anh.			
Tr.			
H.	4270		
Tr.	4287		
Dg.			
BL.	4452		
L.		4472	2249
K.C.	4469		2246
B.K.C.	4925		2702
Ce.	5071	5056	2833
C.			
M.	5169	5164	2941
M.			
K.			
Mz.			
Ma.			
V.			
S.			
S.			
A.			
R.			
PE.			
G.			
T.D.	5254		

Loc. in Sec. C S $\frac{1}{2}$  NE SW

Geol. \_\_\_\_\_  
 Contr. \_\_\_\_\_  
 Trans-Era

Pool

COMPLETE			

Date Comm. 11-22-55 APR 25 1956

20" @ 98/377 DST 5110-26 open 1 hr.

rec. 135' mud 170/30" DST 5110-26

open 1 hr. rec. 12' mud 0/30"

DST 5180-5204 open 1 hr. rec. 3' mud

32/60" DST 5206-54 open 2 hr.

rec. 2500' gas 180' vghocm 264/30"

5 $\frac{1}{2}$ " @ 5205/125 GO to 5254 B/ 10 go 1 hr.

SD 12 hr. FU 100' oil PB 5225

OVER

MAY 4 1956

R.G.

SD 12 hr. FU 600' oil 500 A SD.12 hr.  
FU 2000' oil S/2 $\frac{5}{8}$  boph SD 12 hr.  
FU 2000' oil S/3 boph frac  
FU 1000' fluid S/13 boph  
P/80 bopd 7 days P/35 bopd  
Comp. 35-bopd 30% wtr.

County Clark Elev. 2223 RB  
 Sec. 4 Twp. 31 Rge. 21W  
 Company Stearns Pat. Inc.  
 Farm Name Dailey No. 1

Co.

TOPS	DEPTH	LOG	DATUM
Anh.			
Tr.			
H.			
Tr.			
Dg.			
BL.			
L.			
K.C.			
B.K.C.			
Ce.			
C.			
M.			
M.			
K.			
Mz.			
Me.			
V.			
S.			
S.			
A.			
R.			
Pe.			
G.			
T.D.			

Loc. in Sec. C NE SW  
 Geol. \_\_\_\_\_  
 Contr. Trans-Era  
 Pool \_\_\_\_\_

Lse.

FIRST REPORT		
NOV 30 '55		

T

No.

Date Comm. 11-22-55 Northern Nat. FO  
20" @ 98/377 drlg. 3145

Sec.

T.

R.

*[Handwritten signature and scribbles]*

DEC 2 1955

Scout Cards	..... <i>19</i>
Land Small Map	.....
Land Wall Map	.....
Tracings	.....
France Map	.....
Printing Map	.....
Misc.	.....