


Section 4 Township 31 Range 8W
Well No. #1 Culver
Company Mull Drlg. Co.

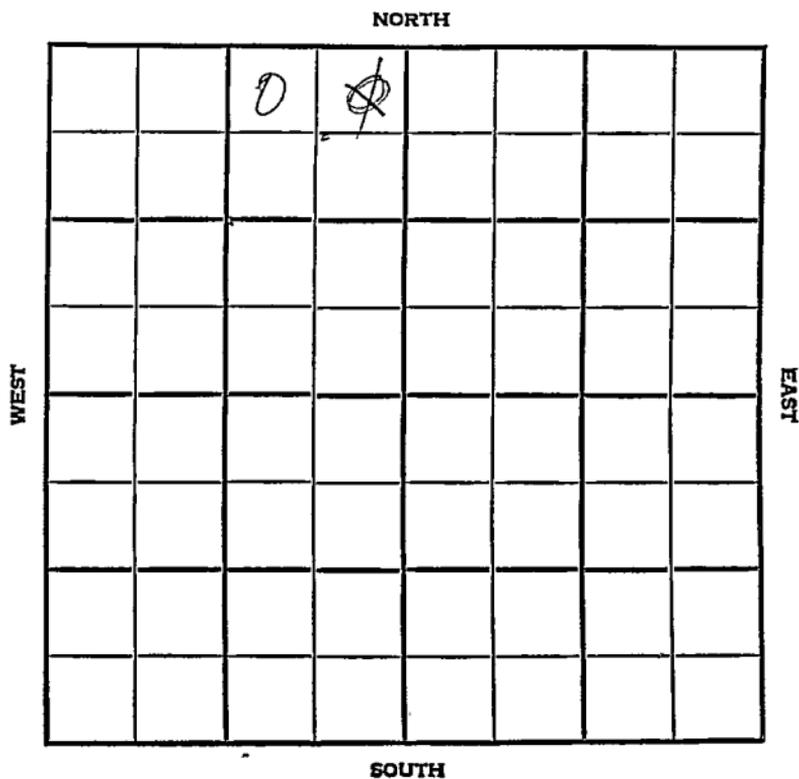

County Harper Elev. _____
 Sec. 4 Twp. 31 Rge. 8W
 Company Mull Drlg. Co.
 FarmName Culver No. 1

TOPS	DEPTH	LOG	DATUM
Anh.			
Tp.			
H.			
Tr.			
Dg.			
Bl.			
L.			
K.C.			
B.K.C.			
Ce.			
C.			
M.			
M.			
K.			
Mz.			
Mq.			
V.			
S.			
S.			
A.			
R.			
PE.			
G.			
T.D.			

Loc. in Sec. NE NE NW App.
 Geol. _____
 Contr. _____
 Co. Tools _____
 Pool _____
 Spivey Grabs _____

0	
Oct 31 '56	
FIRST REPORT	
<u>1/4 mile</u>	

Date Comm. and 10-29-56
8" @ 160 w/150

(mirrored text)
 S. V. W. W.
 R. P.

(handwritten signature)

Co.
 Sec.
 No.
 Sec.
 T.
 R.

CORRECTION

FORM 513 SUNRAY

County Harper Elev. 1067
 Sec. 4 Twp. 31 Rge. 8W
 Company Mull Drlg. Co.
Culver No. 1

	DEPTH	LOG	DATUM
Tp			
H			
Tr			
Dg			
Bl			
L			
K.C.			
B.K.C.			
Ce			
C			
M	<u>4401</u>		
M			
K			
Mz			
Mo			
V			
S			
S			
A			
R			
PE			
G			
TD	<u>4412</u>		

Loc. in Sec. NE NE NW ADD
11W

Geol. _____
 Contr. _____
 Co. Tools _____
 Pool _____
 Spivey Grabs _____

0.2
 1/4 mile
 COMPLETE
 JAN 9 '57

Date Comm. spd. 10-29-56
8" @ .160 w/150 NOV '56 ID 3925 NOV 13 '56
DST 4402-10 4 2 hrs run
60' 0E GCM + 35' 9SSY oily Md
75' 9SSY oil + 5' MW BHP
800/20 5 1/2 @ 4412/150 CO
36/4404-10 1/2 \$ 1.17 Boph
Frac 6 x 4 NOV 21 '56 \$ 4 1/2 Boph
notw ~~11/2~~ NOV 21 '56 DEC '56 DEC 12 '56
DEC 26 '56 JAN 2 '57 Flowed 23 1/2
Bopd + 967 MCFGDD