
Harper KANSAS

DX 78-1

Section 4 Township 31 Range 8W

Well No. 1 Zora Sanders

Company Republic Natural

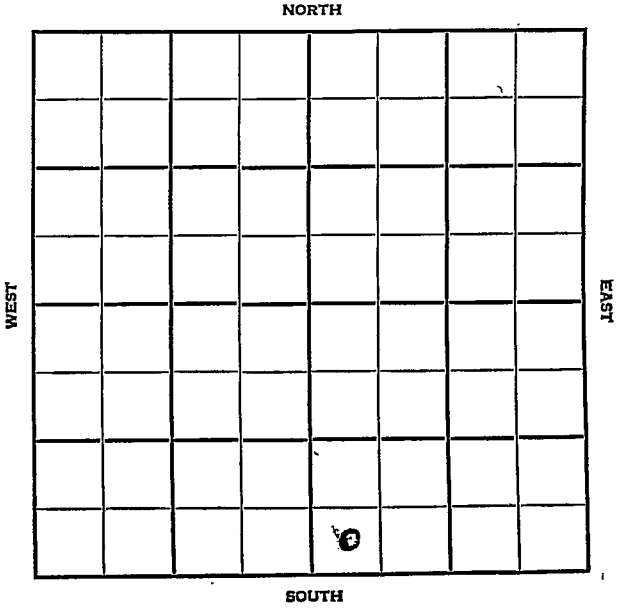

Harper KANSAS

SEC.	TWP.	R.
4	31	8W

WELL NO.

1 Zora Sanders FARM

COMPANY

Republic Natural

CONTRACTOR

Purcell & Mull


E. Grabs Pool

_____ Ft. from N. Line

330 Ft. from S. Line

_____ Ft. from E. Line

330 Ft. from W. Line

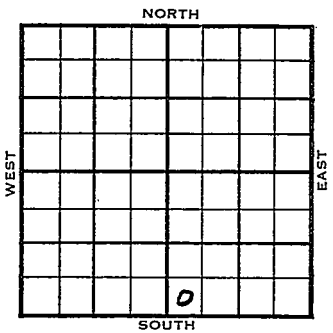

SW SW SE

1954	ELEVATION 1666' REPORT
7/7	Spudding 7-2-54 10" @ 156 Drlg. 1690
7/21	Miss 4408
7/28	Spud 7-2-54 - 10" @ 156' Lans 3654', Miss 4408' TD 4515' D&A

ABANDONED

4408
1666
2742

DX-78

FORM 275 FOR SALE BY KANSAS BLUE PRINT CO.


County Harper State Kansas

Sec. 4 (Blk. Twp.) 31 (Sur. Rge.) SW Map No.

Operator Republic Natural

Well No. 1 Farm Zora Sanders

Elev. Location SW SW SE

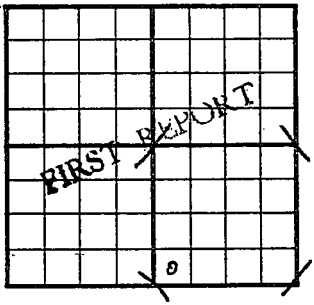

330 Ft. From S Line SE

330 Ft. From W Line Quarter

1st. Report JUL 7 1954

Completion

Remarks Purcell & Mull - Contr.

Spudding Date 7-2-54

Drlg. Data E. Grabs Pool

10" @ 156 drlg. 1690

J. G. McGEHEE

JUL 12 1954

Scout Cards	
Land Small Map	
Land Wall Map	
Tracings	
France Map	
Pierre Map	
Misc.	

Drlg. Data

FORM 275 FOR SALE BY KANSAS BLUE PRINT CO.


County Harper State Kansas

Sec. 4 (Blk. Twp.) 31 (Sur. Rge.) 8W Map No.

Operator Republic Natural

Well No. 1 Farm Zora Sanders

Elev. 1666 Location SW SW SE

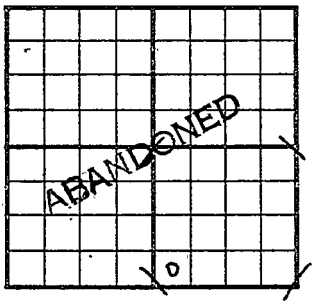

330 Ft. From S Line SE

330 Ft. From W Line Quarter

1st. Report

Completion JUL 2 8 1954

Remarks E. Grabs Pool
Purcell & Mull - Contr.

Spudding Date 7-2-54

Drlg. Data

10" @ 156 Lans. 3654 Miss. 4408 TD 4[illegible]

TD 4515

D & A

J. G. McGEHEE

AUG 4 1954

Scout Cards ..... 1 ea
Land Small Map .....
Land Wall Map 3
Tracings .....
France Map .....
Pi[illegible]e Map .....
Misc. .....

Drlg. Data