


Harper

KANSAS

DX 78-1

Section 4 Township 31 Range 9W  
Well No. #1 Freeland "B"  
Company Petroleum Inc.

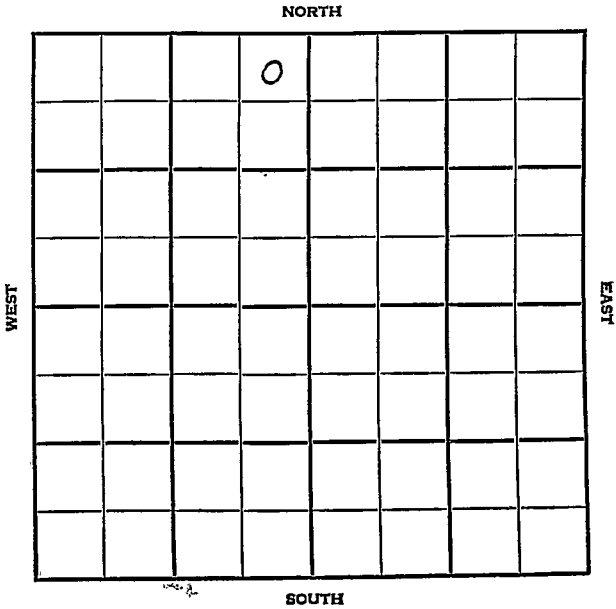

# Harper

KANSAS

|      |      |    |
|------|------|----|
| SEC. | TWP. | R. |
| 4    | 31   | 9W |

WELL NO.

#1 Freeland "B"

FARM

COMPANY

Petroleum Inc.

CONTRACTOR

Garvey


Wildcat.

330 Ft. from N. Line

Ft. from S. Line

330 Ft. from E. Line

Ft. from W. Line

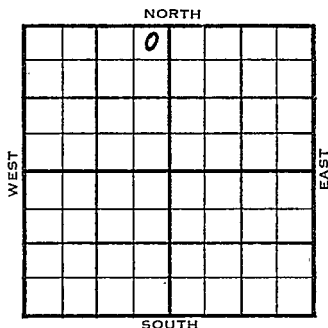

NE NE NW

|      | ELEVATION | REPORT |
|------|-----------|--------|
| 1955 | 1714'     |        |

4/6 Spud 3-30-55  
8" @ 195'  
Drlg. 3275'

4/20 Spud 3-30-55 TD 4505' D & A  
8" @ 195' Tor. 3544 Doug 3562  
Doug sd 3594  
DST 3562-3610 open 1/2 hr. rec 1190'  
SW 1275# Lans 3726 Miss 4422  
DST 4427-45 open 1 hr gas in 15 min  
rec 61' GCM, 1320#  
DST 4428-65 open 1 1/2 hr rec 91' GCM  
TD 4505' D & A

**ABANDONED**

County Harper State KansasSec. 4 (Blk. Twp.) 31 (Sur. Rge.) 9W Map No.Operator Petroleum Inc.Well No. 1 Farm Freeland "B"Elev. Location NE NE NW

|  |  |  |   |  |  |  |  |
|--|--|--|---|--|--|--|--|
|  |  |  | 0 |  |  |  |  |
|  |  |  |   |  |  |  |  |
|  |  |  |   |  |  |  |  |
330 Ft. From N Line NW330 Ft. From E Line Quarter1st. Report APR 6 1955

Completion

Remarks

Garvey - Contr.Spudding Date 3-30-55Drlg. Data Wildcat8" @ 195 drlg. 3275

FABEN GILSTRAP

