

STATE CORPORATION COMMISSION OF KANSAS
OIL & GAS CONSERVATION DIVISION
WELL COMPLETION OR RECOMPLETION FORM
ACO-1 WELL HISTORY
DESCRIPTION OF WELL AND LEASE

Operator: License # 5703
Name J. M. Huber Corporation
Address 7120 I-40 West, Suite 232
City/State/Zip Amarillo, Texas 79106
Purchaser Oil - Petro Source Corp.
Gas - Williams Gas Marketing Co.
Operator Contact Person William D. Siddens
Phone 806/353-9837
Contractor: License # 3363
Name Service Drilling Co.
Wellsite Geologist N/A
Phone

Designate Type of Completion
☒ New Well ☐ Re-Entry ☐ Workover
☒ Oil ☐ SWD ☐ Temp Abd
☐ Gas ☐ Inj ☐ Delayed Comp.
☐ Dry ☐ Other (Core, Water Supply etc.)
If **OWWO**: old well info as follows:
Operator
Well Name
Comp. Date Old Total Depth


WELL HISTORY

Drilling Method:
☒ Mud Rotary ☐ Air Rotary ☐ Cable
12-9-88 12-21-88 1-13-89
Spud Date Date Reached TD Completion Date
5450' 5394'
Total Depth PBTD
Amount of Surface Pipe Set and Cemented at 1681 feet
Multiple Stage Cementing Collar Used? Yes No
If yes, show depth set feet
If alternate 2 completion, cement circulated
from feet depth to w/ SX cmt
Cement Company Name Dowell Schlumberger
Invoice # N/A

SIDE ONE

API NO. 15-129-20,946
County Morton
190 SW of East
C NW SW Sec. 4 Twp 31S Rge 40 X West
1800 Ft North from Southeast Corner of Section
4680 Ft West from Southeast Corner of Section
(Note: Locate well in section plat below)
Lease Name Williams Well # 4-2
Field Name Will-Bros. (Morrow)
Producing Formation Morrow
Elevation: Ground 3290' KB 3299'

Section Plat

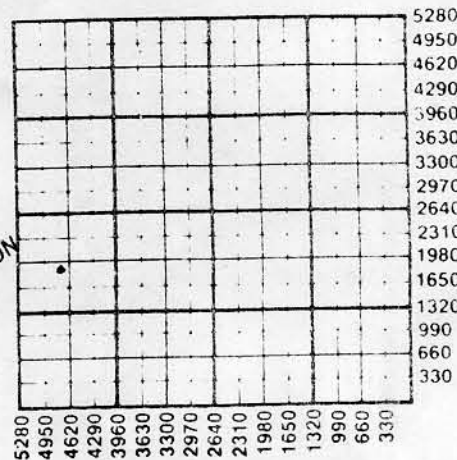

WATER SUPPLY INFORMATION

Disposition of Produced Water: Disposal
Docket # Repressuring

Questions on this portion of the ACO-1 call:
Water Resources Board (913) 296-3717

Source of Water:
Division of Water Resources Permit #
Groundwater Ft North from Southeast Corner
(Well) Ft West from Southeast Corner of
Sec Twp Rge East West
Surface Water Ft North from Southeast Corner
(Stream, pond etc) Ft West from Southeast Corner
Sec Twp Rge East West
X Other (explain) Purchased from Mr. Charles William
Rt. 2, Box 34 Johnson, Kansas 67853
(purchased from City, R.W.B. #)

INSTRUCTIONS: This form shall be completed in triplicate and filed with the Kansas Corporation Commission, 200 Colorado Derby Building, Wichita, Kansas 67202, within 120 days of the spud date of any well. Rule 82-3-130, 82-3-107 and 82-3-106 apply.
Information on side two of this form will be held confidential for a period of 12 months if requested in writing and submitted with the form. See rule 82-3-107 for confidentiality in excess of 12 months.
One copy of all wireline logs and drillers time log shall be attached with this form. Submit CP-4 form with all plugged wells. Submit CP-111 form with all temporarily abandoned wells.

All requirements of the statutes, rules and regulations promulgated to regulate the oil and gas industry have been fully complied with and the statements herein are complete and correct to the best of my knowledge.

Signature Robert R. Glenn
Title District Production Manager Date 1-26-89

Subscribed and sworn to before me this 26th day of January 1989
Notary Public Deniese L. Barnett
Date Commission Expires 6-26-89

K.C.C. OFFICE USE ONLY		
☒	Letter of Confidentiality Attached	
☒	Wireline Log Received	
☒	Drillers Timelog Received	
Distribution		
☒	KCC	☐ SWD/Rep
☒	KGS	☐ Plug
		☐ NGPA
		☐ Other
		(Specify)

Form ACO-1 (5-86)

KANSAS GEOLOGICAL SURVEY
WICHITA BRANCH