

5-31-40W *9nd*

SIDE ONE

STATE CORPORATION COMMISSION OF KANSAS  
OIL & GAS CONSERVATION DIVISION  
WELL COMPLETION OR RECOMPLETION FORM  
ACO-1 WELL HISTORY  
DESCRIPTION OF WELL AND LEASE

S.C.

API NO. 15-129,20,954

County... Morton  
Approx. C. NW SE Sec. 5... Twp 31S... Rge. 40... East XX West

Operator: License # ... 5703  
Name ... J. M. Huber Corporation  
Address ... 7120 I-40 West, Suite 232  
City/State/Zip ... Amarillo, Texas 79106

1810 Ft North from Southeast Corner of Section  
2000 Ft West from Southeast Corner of Section  
(Note: Locate well in section plat below)

Purchaser... None

Lease Name... Williams Well # 5-2

Operator Contact Person... William D. Siddens  
Phone ... (806) 353-9837

Field Name... Will-Bros (Morrow) Field

Contractor: License # ... 5107  
Name ... H-30 Drilling


Producing Formation... None (D&A)

Wellsite Geologist... N/A  
Phone...

Elevation: Ground... 3301' KB... 3313'

Designate Type of Completion  
 New Well  Re-Entry  Workover  
 Oil  SWD  Temp Abd  
 Gas  Inj  Delayed Comp.  
 Dry  Other (Core, Water Supply etc.)

Section Plat

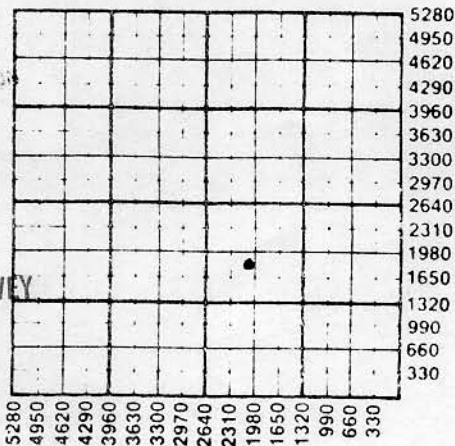

RECEIVED  
MAY 12 1989  
KANSAS GEOLOGICAL SURVEY  
WICHITA BRANCH

If OWWO: old well info as follows:  
Operator  
Well Name  
Comp. Date ... Old Total Depth

WATER SUPPLY INFORMATION

Disposition of Produced Water: Disposal  
Docket # ... Repressuring

WELL HISTORY

Drilling Method:  
 Mud Rotary  Air Rotary  Cable

4-10-89... 4-20-89... 4-21-89...  
Spud Date Date Reached TD Completion Date

5475...  
Total Depth PBDT

Amount of Surface Pipe Set and Cemented at 1670 feet  
Multiple Stage Cementing Collar Used? Yes  No  
If yes, show depth set... feet  
If alternate 2 completion, cement circulated from... feet depth to... w/... SX cmt  
Cement Company Name... B. J. Titan  
Invoice #

Questions on this portion of the ACO-1 call:  
Water Resources Board (913) 296-3717

Source of Water:  
Division of Water Resources Permit #

Groundwater... Ft North from Southeast Corner (Well) ... Ft West from Southeast Corner of Sec Twp Rge East West

Surface Water... Ft North from Southeast Corner (Stream, pond etc)... Ft West from Southeast Corner Sec Twp Rge East West

Purchased from  
 Other (explain)... Charles Williams  
Irrigation (purchased from city, R.W.D. #)  
Well 1/4 mile NE Section 5-31S-40W

INSTRUCTIONS: This form shall be completed in triplicate and filed with the Kansas Corporation Commission, 200 Colorado Derby Building, Wichita, Kansas 67202, within 120 days of the spud date of any well. Rule 82-3-130, 82-3-107 and 82-3-106 apply.

Information on side two of this form will be held confidential for a period of 12 months if requested in writing and submitted with the form. See rule 82-3-107 for confidentiality in excess of 12 months. One copy of all wireline logs and drillers time log shall be attached with this form. Submit CP-4 form with all plugged wells. Submit CP-111 form with all temporarily abandoned wells.