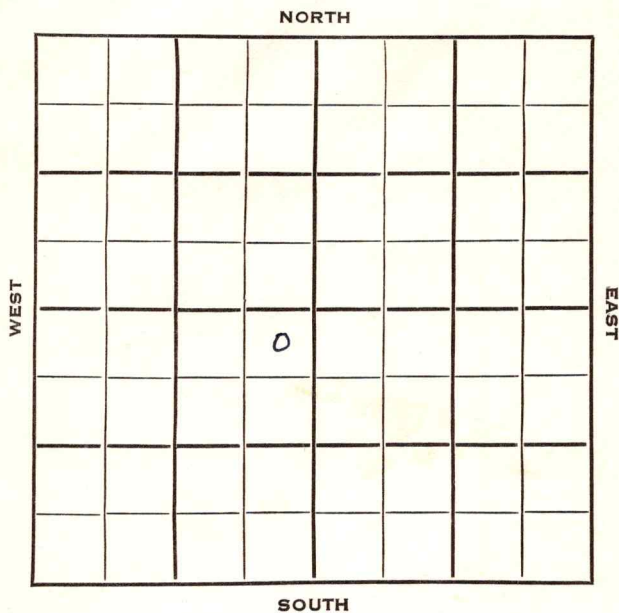


Section 3 Township 31 Range 40WWell No. 2 WilliamsCompany Kansas Natural Gas

Morton


KANSAS ✓

Sec. 3 Twp. 31 R. 40WWell No. #2 Williams FarmKansas Natural Gas Company

Contractor

100 Ft. from N. Line Ft. from S. Line100 Ft. from E. Line Ft. from W. Line

NE SW

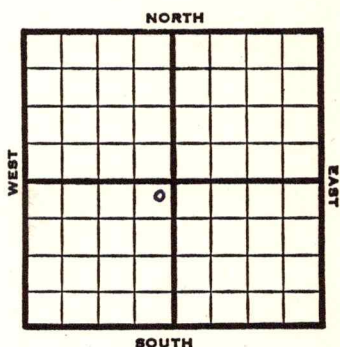

1953 Elev. 3266' REPORT

1953
1/14

Location

1/22

"

1/29

"

2/5

"

2/12

"

2/19

10" @ 273

RTD 2359

5" @ 2358

Her 2292, Kri 2314, Win 2359

2/26

N.R.

3/12

DD 2367 TD

PB 2355

60/2296-2306, 60/2314-22,

CO 2367, 1750A

3/18

Spud 2-6-53 Gas well TD 2367

10" @ 273 TD 2359 5" @ 2358

Her. 2292 Kri 2314 Win 2359

DD 2367 PB 2355 60/2296-2306

60/2314-22 CO to 2367 3750 A


dolo-frac.

Comp. 1,605,000 gas.

COMPLETED

J. G. McGEHEE

County Morton State Kansas
 Sec. 3 (Blk.) 31 (Sur.) 40W Map No.
 Operator Kansas Natural Gas
 Well No. 2 Farm Williams
 Elev. 3266 Location NE SW

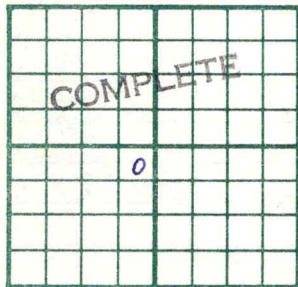

100 Ft. From N Line SW
100 Ft. From E Line Quarter

1st. Report

Completion MAR 18 1953

Remarks

Spudding Date 2-6-53

Drlg. Data Gas well TD 2367

10" @ 273 TD 2359 5" @ 2358

Her. 2292 Kri. 2314 Win. 2359

DD 2367 PB 2355 60/ 2296-2306

60/ 2314-22 CO to 2367 3750 A

dolo-frac Comp. 1,605,000 gas

J. G. McGEHEE