

Morton


FORM 51 IOM 12-46 PETROL

KANSAS

Section 1 Township 31 Range 40W
~~4W~~

Well No. 1 Brehn

Company Stanolind

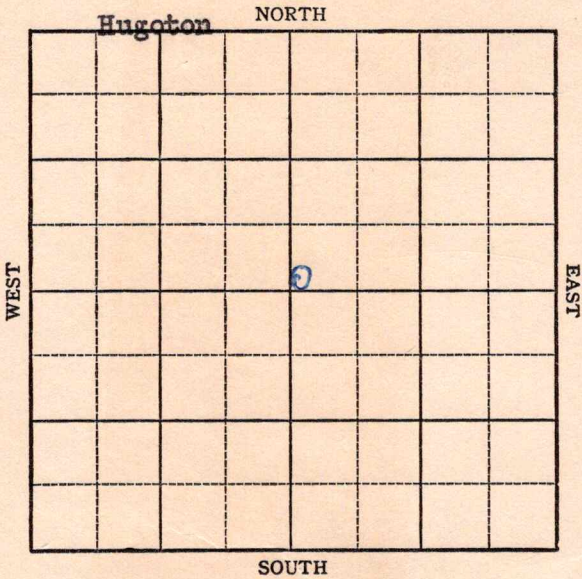

Morton

Sec. 1 **KANSAS**

Twp. 31

R. 40W

Well No. #1 Brehn Farm
Stanolind

Company

Hugoton

Ft. from N. Line

100


Ft. from S. Line

Ft. from E. Line

100

Ft. from W. Line

SW NE

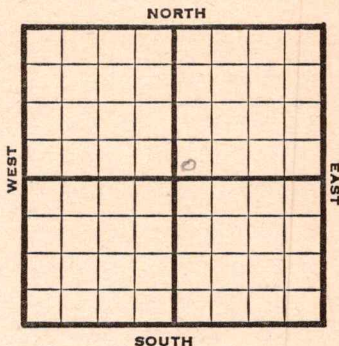

1947

Elev. 3245

REPORT

9/10

10" @ 645
TD, 2419

9/17

7" @ 2419'

9/24

TD 2638
5" @ 2598'
3000 Acid
84 shots 2544-60 - 2500 Acid
240 " 2470-2510 - 5500 "

10/1

7" @ 2419
5" @ 2598
18000 Acid
6,115,000 Gas
TD 2683
400# R Pr.

COMPLETED

Map No. _____ Sec. 1 Twp. 31 R. 40W

Well No. 1 Brehn

Stanolind Company

FIRST REPORT

Contractor _____

SW NE


SECTION PLAT

_____ Ft. from N. Line

100 Ft. from S. Line

_____ Ft. from E. Line

100 Ft. from W. Line

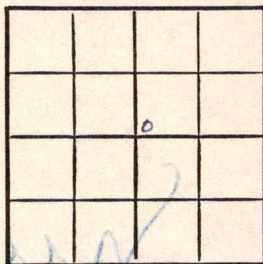

Morton County

Location _____

Rig up _____

Drilling and Remarks:

10" @ 645

TD 2419

RECORD

Cased _____ in., _____ ft.

Sand _____

Gas _____

Oil _____

Total Depth _____

PRODUCTION

1st 24 hrs. Nat. _____

1st 24 hrs. after shot _____

Gas _____ Cu. Ft.

Dry Hole _____

Abandoned _____

Date

SEP 10 1947

19

S. J. LEWIS

Scout

Map No. 0 Sec. 1 Twp. 31 R. 4 OW

Well No. 1 Brehn

Stanolind Company

COMPLETE

Contractor

SW NE

E13245

SECTION PLAT

		0	

 Ft. from N. Line

100 Ft. from S. Line

 Ft. from E. Line

100 Ft. from W. Line

Morton County

Location

Rig up

Drilling and Remarks:

7 "62419"
5 "02558"
18000 sand
6, 115,000 Gas

400 # RPE

RECORD

Cased in., ft.

Sand

Gas

Oil

Total Depth *2635*

PRODUCTION

1st 24 hrs. Nat.

1st 24 hrs. after shot

Gas Cu. Ft.

Dry Hole

Abandoned

Date

OCT 1 1947 19

S. J. LEWIS Scout