


Section 2 Township 31 Range 40W

Well No. 1 Evans

Company Kansas-Nebraska

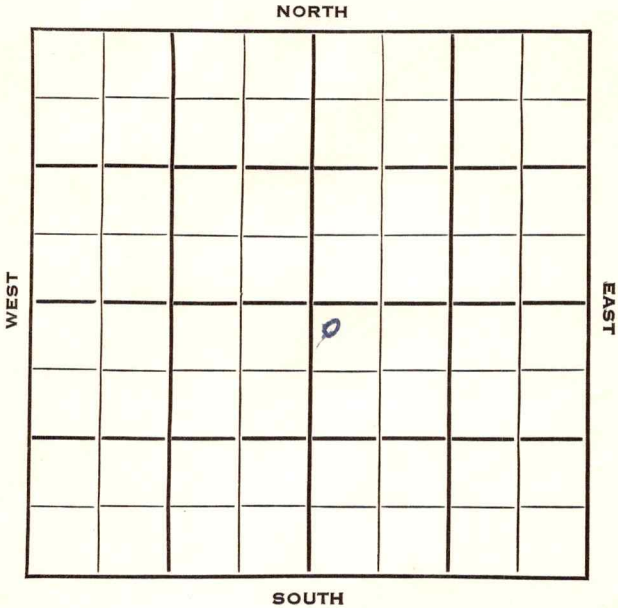

Morton

KANSAS

SEC.	TWP.	R.
2	31	40 W

WELL NO.

1 Evans

FARM

COMPANY

Kansas-Nebraska

CONTRACTOR

Hugoton Pool


150 Ft. from N. Line

Ft. from S. Line

Ft. from E. Line

150 Ft. from W. Line

NW NW SE

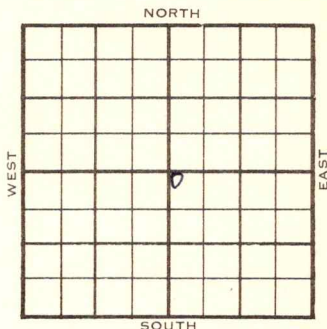

1954

ELEVATION

3268'

REPORT

3/3

Location

3/17

8" @ 378' w/250 sks

RTD 2467'

5" @ 2467'

5/19

Spud 3-9-54

Gas Well

TD 2467'

8" @ 378'

Kri 2376', Her. 2358', Win 2440'

TD 2467'

5" @ 2467'

CO to 2458'

108/ 2380-98 120/ 2416-36

36/ 2442-48 frac. 1 mcfg.

2000 A

Comp open flow 636,000 cfpd.

COMPLETED

1

2

Г

D.

10

FIRST REPORT

150

Ft. From

N

Line

SE

150

Ft. From

11

Line

Quarter

1st. Report

MAR

3

1954

Completion

Remarks

Spudding Date

Drlg. Data

Hugoton Pool

Location

County Morton State Kansas
 Sec. 2 (Blk.) 31 (Sur.) 4 OW Map No.
 Operator Kansas-Nebraska
 Well No. 1 Farm Evans
 Elev. 3268 Location NW NW SE



150 Ft. From N Line SE
150 Ft. From W Line Quarter
 1st. Report ..
 Completion MAY 19 1954
 Remarks Hugoton Pool

Spudding Date 3-9-54
 Drlg. Data Gas well TD 2467
8" @ 378 Her. 2358 Kri. 2376
Win. 2440 TD 2467 5" @ 2467
CO to 2458 108/ 2380-98 120/ 2416-36
36/ 2442-48 frac 1 mcfg 2000 A
Comp. open flow 636,000 cfcpd

J. G. McGEHEE