
FORM 51 Morton

KANSAS

Section 15 Township 31 Range 40W

Well No. 1 Atkinson

Company Kansas Natural

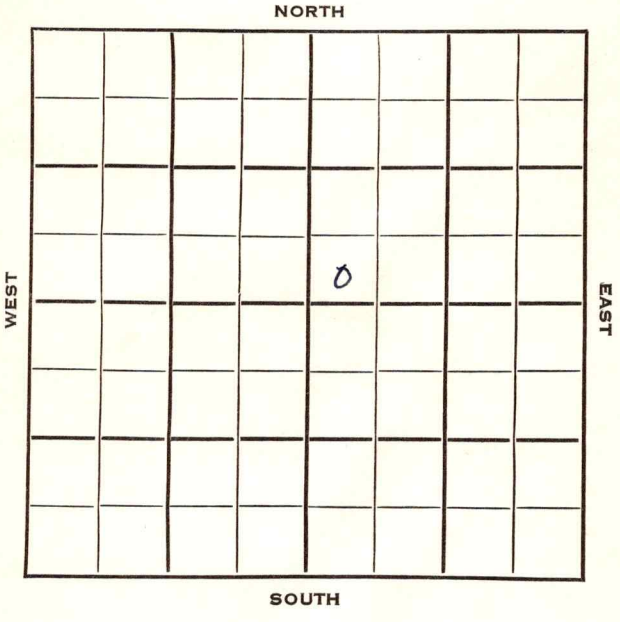

FORM 252-B

KANSAS ✓

Sec. 15 Twp. 31 Morton R. 40W

Well No. #1 Atkinson Farm

Kansas Natural Company

Contractor


Ft. from N. Line

100 Ft. from S. Line

Ft. from E. Line

100 Ft. from W. Line

SW NE

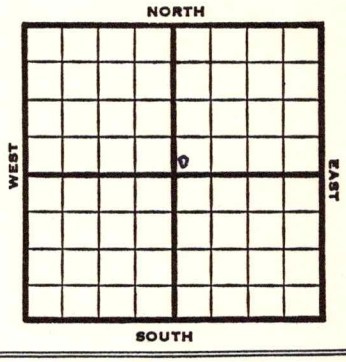

1953	Elev. 3301' REPORT
1/14	Location
1/22	"
1/29	"
2/5	Drlg. 320'
2/12	10" @ 370 RTD 2359, 7" @ 2358 Her 2290, Kr 2310, Win 2357
2/19	NR
2/26	C.O.
3/12	CO 2357, 500A 4000 dol-frac PB 2340 36/2294-2300, 24/2312-16, 60/2320-30, 1000A sq
3/18	Gas well TD 2359' 10" @ 370 TD 2359 7" @ 2354 Her. 2290 Kri. 2310' Win. 2357 CO to 2357 500 A 4000 A dolo-frac PB 2340 36/2294-2300 24/2312-16 60/2320-30 1000 A Comp. 1,790,000 gas.

COMPLETED

FORM 275 FOR SALE BY KANSAS BLUE PRINT CO.


County Morton State Kansas

Sec. 15 (Blk. Twp.) 31 (Sur. Rge.) 40W Map No.

Operator Kansas Natural

Well No. 1 Farm Atkinson

Elev. 3301 Location SW NE

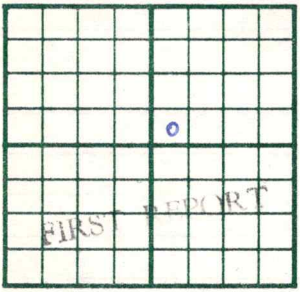

100 Ft. From S Line NE

100 Ft. From W Line Quarter

JAN 14 1953

1st. Report

Completion

Remarks

Spudding Date

Drlg. Data

Location

J. G. McGEHEE

FORM 275 FOR SALE BY KANSAS BLUE PRINT CO.

County Morton State Kansas

Sec. 15 (Blk. Twp.) 31 (Sur. Rge.) 40W Map No.

Operator Kansas Natural Gas

Well No. 1 Farm Atkinson

Elev. 3301 Location SW NE



100 Ft. From S Line NE

100 Ft. From W Line Quarter

1st. Report

Completion MAR 1 8 1953

Remarks

Spudding Date

Drlg. Data Gas well TD 2359

10" @ 370 TD 2359 7" @ 2354

Her. 2290 Kri. 2310 Win. 2357

CO to 2357 500 A 4000 A dolo-frac

PB 2340 36/ 2294-2300 24/ 2312-16

60/ 2320-30 1000 A

Comp. 1,790,000 gas

J. G. McGEHEE