


Section 12 Township 31 Range 40-W

Well No. #1 Allen

Company Stanolind
Hugoton Pool

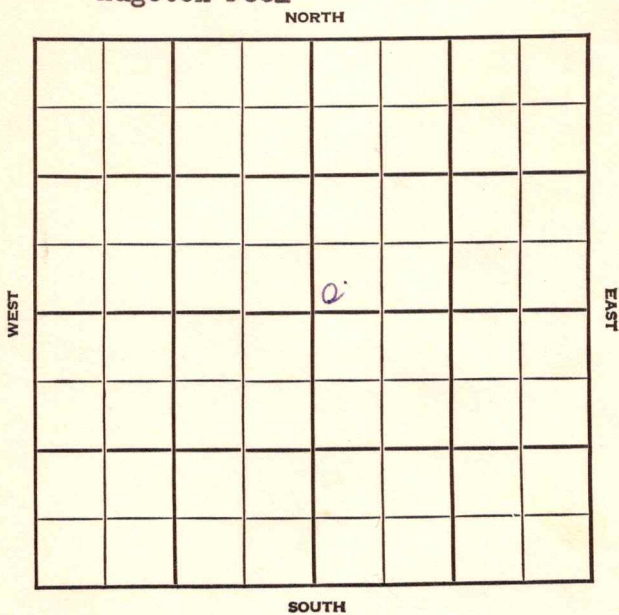

Sec. 12 Twp. 31 R. 40W

Well No. #1 Allen Farm

Stanolind Company

Hugoton Pool


Ft. from N. Line

150' Ft. from S. Line

Ft. from E. Line

150' Ft. from W. Line

SW NE

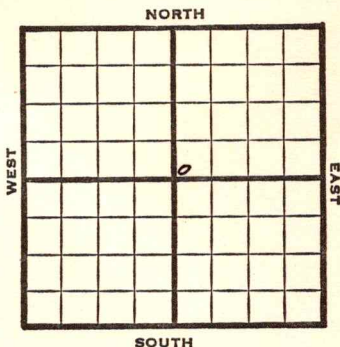

1948

Eli 3241'

REPORT

5/26

Location

6/1

RUR

6/9

10" @ 645'
Drlg. 2570'

6/16

TD 2630'
7" @ 2581'
3000 Acid

6/23

180 shots 2526-56 4500 acid
204 " 2460-94 4000 " water
PB 2494 - 3500 Acid

6/29

276 shots 2394-2440-6500 acid wtr.
PB 2621

7/14

TD 2630'
7" @ 2581'
Perf 15,000 Acid
7,820,000 Gas
428#R PR.

Comp

COMPLETED

Map No. _____ Sec. 12 Twp. 31 R. 40W

Well No. 1 Allen

Stanolind Company

FIRST REPORT

Contractor

SW NE

SECTION PLAT

_____ Ft. from N. Line

150 Ft. from S. Line

_____ Ft. from E. Line

150 Ft. from W. Line

Morton County

Location X

Rig up _____

Drilling and Remarks:

RECORD

Cased _____ in., _____ ft.

Sand _____

Gas _____

Oil _____

Total Depth _____

PRODUCTION

1st 24 hrs. Nat. _____

1st 24 hrs. after shot _____

Gas _____ Cu. Ft.

Dry Hole _____

Abandoned _____

Date

MAY 26 1948 19

S. J. LEWIS Scout

Map No. _____ Sec. 12 _____ Twp. 31 _____ R. 40W

Well No. 1 Allen _____

Stanolind _____ Company

COMPLETE _____ Contractor

SW NE

E 1,3241
SECTION PLAT

_____ Ft. from N. Line

150 _____ Ft. from S. Line

_____ Ft. from E. Line

150 _____ Ft. from W. Line

		0	

Morton County

Location _____

Rig up _____

Drilling and Remarks:

7" @ 2587

10000

100000000

7,820,000 Gas

425-212

RECORD

Cased _____ in., _____ ft.

Sand _____

Gas _____

Oil _____

Total Depth 2600

PRODUCTION

1st 24 hrs. Nat. _____

1st 24 hrs. after shot _____

Gas _____ Cu. Ft.

Dry Hole _____

Abandoned _____

Date

JUL 14 1948

19

S. J. LEWIS

Scout