
FORM 51 Morton KANSAS

Section 16 Township 31 Range 40W

Well No. 1 Milburn

Company Kansas Natural

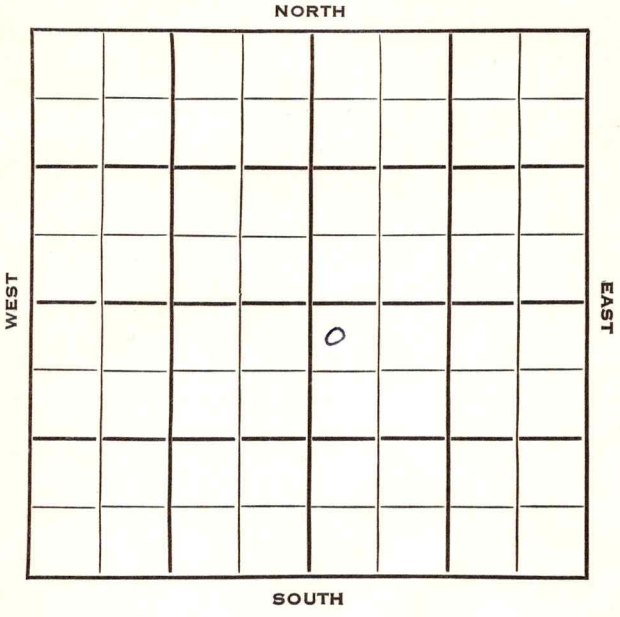

FORM 252-B

Morton KANSAS ✓

Sec. 16 Twp. 31 R. 40W

Well No. #1 Milburn Farm

Kansas Natural Company

Contractor


100 Ft. from N. Line

Ft. from S. Line

Ft. from E. Line

100 Ft. from W. Line

NW SE

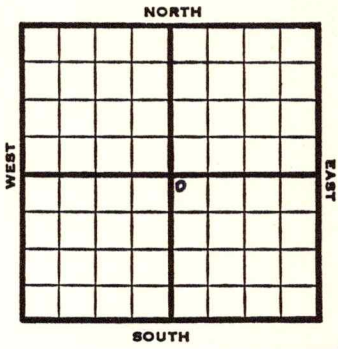

1953 Elev. 3308' REPORT

1/14 Location
1/22 "
1/29 "
2/5 10" @ 365
Her 2232, Kr 2244, Win 2292,
RTD 2306
7" @ 2296
2/12 NR
2/19 "
2/26 C.O. 2306 2500A 60/2234-44 60/2260-20
24/2224-28 2500A 6000 Dol Frac.
3/11 Spud 1-25-53
Gas Well
TD 2306
10" @ 365
Her 2232, Kri 2244, Win 2292
TD 2306
7" @ 2296
CO to 2306, 60/2234-44, 60/2260
70, 24/2224-28, 8500A
dol-frac
Comp. 2,065,000 gas

COMPLETED

FORM 275 FOR SALE BY KANSAS BLUE PRINT CO.

County Morton State Kansas

Sec. 16 (Blk. Twp.) 31 (Sur. Rge.) 40W Map No.

Operator Kansas Natural

Well No. 1 Farm Milburn

Elev. 3308 Location NW SE



100 Ft. From N Line SE

100 Ft. From W Line Quarter

1st. Report JAN 14 1953

Completion

Remarks

Spudding Date

Drlg. Data

Location

J. G. McGEHEE

FORM 275 FOR SALE BY KANSAS BLUE PRINT CO.


County Morton State Kansas

Sec. 16 (Blk. Twp.) 31 (Sur. Rge.) 40W Map No.

Operator Kansas Natural

Well No. 1 Farm Milburn

Elev. 3308 Location NW SE

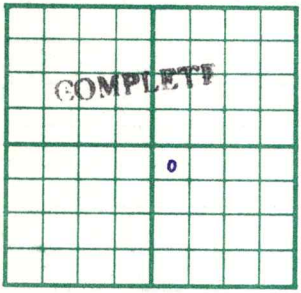

100 Ft. From N Line SE

100 Ft. From W Line Quarter

1st. Report

Completion MAR 1 1 1953

Remarks

Spudding Date 1-25-53

Drlg. Data Gas well TD 2306

10" @ 365 Her. 2232 Kri. 2244

Win. 2292 TD 2306 7" @ 2296 CO to 2306

60/ 2234-44 60/ 2260-70 24/ 2224-28

8500 A dol-frac

Comp. 2,065,000 gas

J. G. McGEHEE