


Section 19 Township 31 Range 40W

Well No. 1 Estelle Smith

Company Huber Corp.

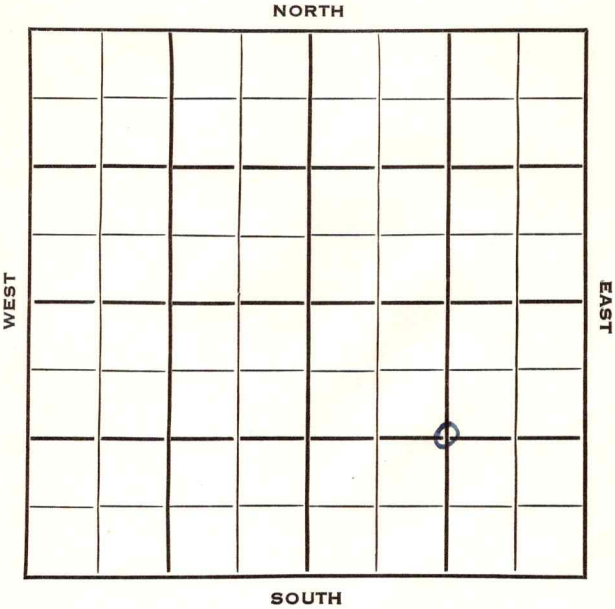

Morton

KANSAS

SEC.	TWP.	R.
19	31	40 W ✓

WELL NO.

1 Estelle Smith

FARM

COMPANY

Huber Corp.

CONTRACTOR

Midwestern


_____ Ft. from N. Line

1320 _____ Ft. from S. Line

1320 _____ Ft. from E. Line

_____ Ft. from W. Line

C SE/4

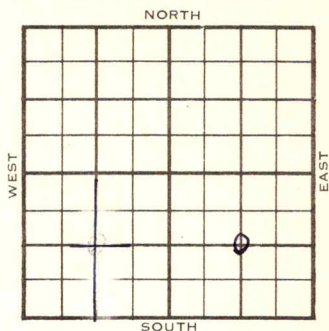

1954

ELEVATION

3331'

REPORT

3/3

Location

3/17

8" @ 472'

3/24

Her. Kr. 2150', Win 2200', Tow
2246',
RTD 2277'
5" @ 2248'

3/31


WOCT

5/5

Spud 3-14-54 Gas well TD 2277
8" @ 472' Her-Kri. 2150 Win. 2200
Tow. 2246 TD 2277 5" @ 2248
CO to 2273 PB 2235 40/2214-24
40/2204-14 16/2200-04 frac.
CO to 2258 Comp. 7½ MCFGPD

COMPLETED

County **Morton** State **Kansas**
 Sec. **19** (Blk.) **31** (Sur.) **40W** Map No.
 (Twp.) (Rge.)
 Operator **Huber Corp.**
 Well No. **1** Farm **Estelle Smith**
 Elev. Location **C SE 4**

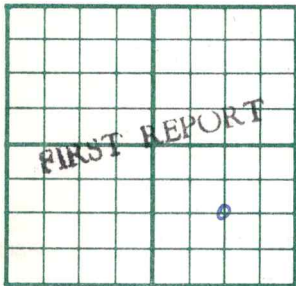

1320 Ft. From **S** Line **SE**
1320 Ft. From **E** Line Quarter
 1st. Report **MAR 3 1954**
 Completion
 Remarks
Midwestern - Contr.
 Spudding Date

Drlg. Data

Location

County Morton State KansasSec. 19 (Blk.
Twp.) 31 (Sur.
Rge.) 40W Map No.Operator Huber Corp.Well No. 1 Farm Estelle SmithElev. 3331 Location C SE/41320 Ft. From S Line SE1320 Ft. From E Line Quarter

1st. Report _____

Completion MAY 5 1954

Remarks _____

Mid-Western - Contr.Spudding Date 3-14-54Drlg. Data Gas well TD 22778" @ 472 Her-Kri. 2150 Win. 2200Tow. 2246 TD 2277 5" @ 2248 CO to 2273PB 2235 40/ 2214-24 40/ 2204-1416/ 2200-04 frac CO to 2258Comp. $7\frac{1}{2}$ mcf gpd

J. G. McGEHEE