
FORM 5T-10M 8-47 Morton County KANSAS

Section 23 Township 31 Range 40W

Well No. #1 Lutz

Company Stanolind

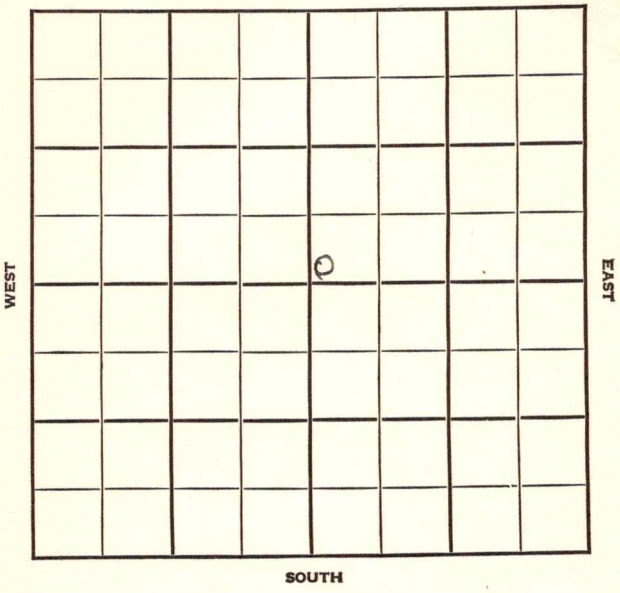

FORM 252-A
5M 9-47 PETROL

Morton KANSAS

Sec. 23 Twp. 31 R. 40W

Well No. #1 Lutz Farm

Stanolind Company

Hugoton


____ Ft. from N. Line

150 Ft. from S. Line

____ Ft. from E. Line

150 Ft. from W. Line

SW NE

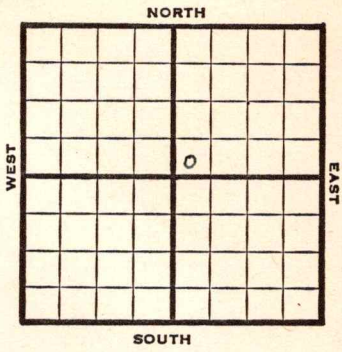


| | REPORT |
|---|---|
| ~~1947~~ | Elev. 3284' |
| 12/17 | 8" @ 605'<br>Drlg. 1685' |
| 1948 | |
| 1/7 | 5" @ 2447'<br>Perf.<br>9,500 Acid<br>Gas 3,531,000<br>Rock Pressure 395#<br>Total Depth 2510'<br>COMPLETED |

Form 26 200 Bks. 10-46 Petrol

Kansas

Hugoton Pool

Map No. _____ Sec. 23 Twp. 31 R. 4 OW


Well No. 1 Lutz

Stanolind Company

FIRST REPORT Contractor

SW NE

SECTION PLAT

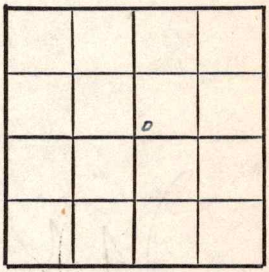

_____ Ft. from N. Line

150 Ft. from S. Line

_____ Ft. from E. Line

150 Ft. from W. Line

Morton County

Location _____

Rig up _____

Drilling and Remarks:

8" @ 605

drlg. 1685

RECORD

Cased _____ in., _____ ft.

Sand _____

Gas _____

Oil _____

Total Depth _____

PRODUCTION

1st 24 hrs. Nat. _____

1st 24 hrs. after shot _____

Gas _____ Cu. Ft.

Dry Hole _____

Abandoned _____

Date

DEC 17 1947 19 S. J. LEWIS Scout

Form 26 200 Bks. 10-46 Petrol

Kansas

Hugoton Pool

Map No. O Sec. 23 Twp. 31 R. 40W

Well No. 1 Lutz


Stanolind Company

COMPLETE Contractor

SW NE

E 1.3284

SECTION PLAT

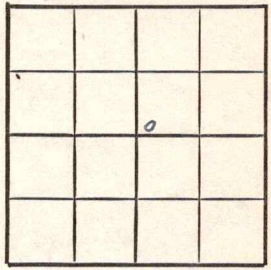

____ Ft. from N. Line

150 Ft. from S. Line

____ Ft. from E. Line

~~150~~ Ft. from W. Line

Morton County

Location

Rig up

Drilling and Remarks:

5" @ 2447'

Perf.

9500 Acid

8,581,000 Gas

890# RP

RECORD

Cased ____ in., ____ ft.

Sand

Gas

Oil

Total Depth 2510

PRODUCTION

1st 24 hrs. Nat.

1st 24 hrs. after shot

Gas ____ Cu. Ft.

Dry Hole

Abandoned

Date

JAN 7 1948 19

S. J. LEWIS Scout