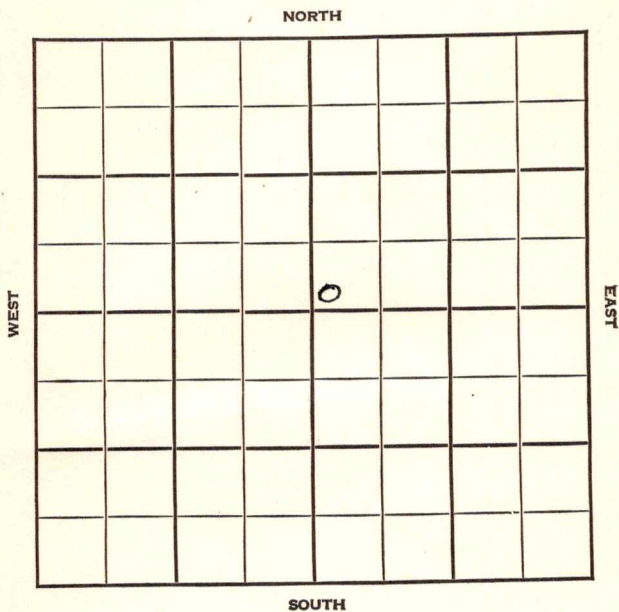


Section 24 Township 31 Range 40WWell No. #1 BrerdingCompany Stanolind

Morton

Sec. 24 **KANSAS** Twp. 31 R. 40W

Well No. #1 Brerding Farm

Stanolind Company


Hugoton Pool

 Ft. from N. Line

150' Ft. from S. Line

 Ft. from E. Line

150' Ft. from W. Line

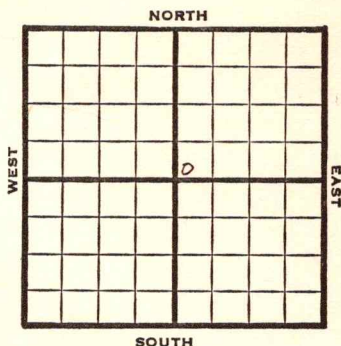

SW NE

1948	El1 3258' REPORT
6/9	Location
6/16	"
6/23	8" @ 605'
6/29	TD 2585 5"@ 2543 RUST
7/8	"
7/14	4,000 acid wbr.
7/21	204 shots 2416-50 5000 acid 246 shots 2353-95 5500 acid
7/28	" "
8/4	"
8/11	"
8/18	"
8/25	"
9/1	5"@ 2543' TD 2585 Perf 13500 acid 4,770,000 gas 432# R Pr. Comp
	COMPLETED

Map No. _____ Sec. 24 Twp. 31 R. 40W

Well No. 1 Brerding

Stanolind Company

IRST REPORT Contractor

SW NE

SECTION PLAT

		o	

_____ Ft. from N. Line

150 Ft. from S. Line

_____ Ft. from E. Line

150 Ft. from W. Line

Morton County

Location X

Rig up _____

Drilling and Remarks:

RECORD

Cased _____ in., _____ ft.

Sand _____

Gas _____

Oil _____

Total Depth _____

PRODUCTION

1st 24 hrs. Nat. _____

1st 24 hrs. after shot _____

Gas _____ Cu. Ft.

Dry Hole _____

Abandoned _____

Date

JUN 9 1948

19

S. J. LEWIS

Scout

Morton County Kansas StateMap No. _____ Sec. 24 Twp. 31 R. 40WWell No. 1 BreedingStanolind CompanyCOMPLETE

Contractor

SW NE

E 1,3258.
SECTION PLAT

_____ Ft. from N. Line

150 Ft. from S. Line

_____ Ft. from E. Line

150 Ft. from W. Line

Hugoton Pool

Remarks:

5" C2543MA2085Perf.18500 and 64,770,000 Gal432 = R₁₂Date
SEP 1 1948Scout
S. J. LEWIS