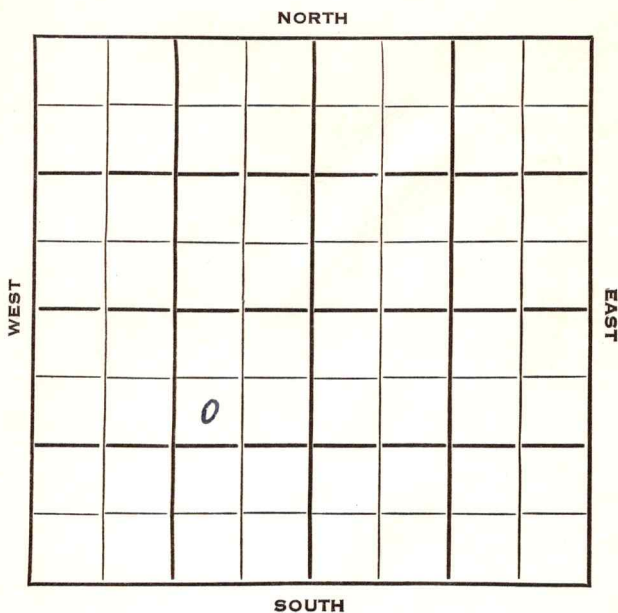


Section 30 Township 31 Range 40 WWell No. # 1 SwindlerCompany Huber Corp

Morton

KANSAS

Sec. 30 Twp. 31 R. 40 WWell No. # 1 Swindler FarmHuber Corp. Company

Contractor


990 Ft. from N. Line

Ft. from S. Line

990 Ft. from E. Line

Ft. from W. Line

SW NE SW

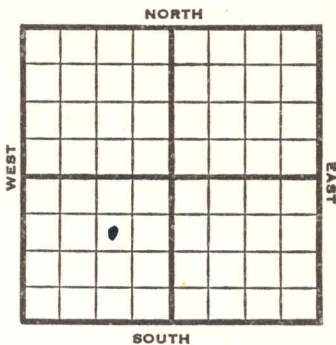

1953 Elev. 3338'

REPORT

8/5	Location
8/12	"
9/2	"
9/9	"
9/16	Spud 8-22-53
	Gas Well
	TD 2268'
	8" @ 558'
	Win. 2163, Tow. 2254,
	TD 2256'
	5" @ 2256'
	DD 2268 1000 A 80/ 2176-96
	SP 2220
	frac.
	Comp. 13,070,000 gas 420#.

COMPLETED

County **Morton** State **Kansas**

Sec. 30 (Blk. Twp.) 31 (Sur. Rge.) 40W Map No.

Operator Huber Corp.

Well No. 1 Farm Swindler

[illegible]

990 Ft. From N Line SW

990 Ft. From **E** Line Quarter

1st. Report AUG 5 1953

Completion


Remarks

Spudding Date _____

Drlg. Data

Location

J. G. McCallum

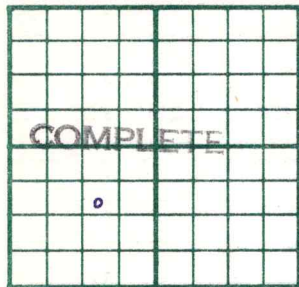County Morton State KansasSec. 30 (Blk.) 31 (Sur.) 40W Map No.Operator Huber Corp.Well No. 1 Farm SwindlerElev. 3338 Location SW NE SW990 Ft. From N Line SW990 Ft. From E Line Quarter1st. ReportCompletion SEP 10 1953RemarksSpudding Date 8-22-53Drlg. Data Gas well TD 22688" @ 558 Win. 2163 Tow. 2254TD 2256 5" @ 2256 DD 2268 1000 A80/ 2176-96 SP 2220 fracComp. 13,070,000 gas 420#