

Morton


KANSAS
KANSAS

SECTION 18 TOWNSHIP 31 RANGE 40W

WELL NO. #1 Breeding

COMPANY Southwestern Exp.

NORTH

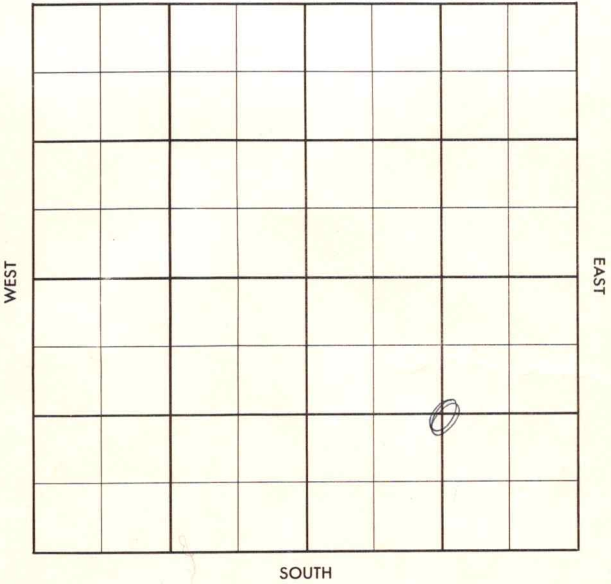

[illegible]

County Morton Elev. 3320
 Sec. 18 Twp. 31 Rge. 40W
 Company Southwestern Exp.
 Farm Name Breeding No. 1

TOPS	DEPTH	LOG	DATUM	Loc. in Sec.
Anh.				C SE
Tr.				
H. <u>KPI</u>		<u>2214</u>		
Tr. <u>WFD</u>		<u>2260</u>		
Dg.				
Bl.				
L.				Geol.
M.C.				Contr.
B.K.C.				Rocket Drlg.
Ce.				
C.				
M.				Pool
M.				Hugoton
K.				
Mz.				
Ma.				
V.				
S.				
S.				
A.				
R.				
PE.				
G.				
T.D.	<u>2300</u>			

ABANDONED
 JAN 30 7

Date Comm.

Location JAN 2 '57 12-27-56 8 5/8

488/300 5 1/2 @ 2300/400 Woct

JAN 9 '57

JAN 15 '57

CO 48/2266-74

9a 100 MFC + 1/2 BWph JAN 23 '57

50d 20 505 JAN 30 '57 PF 2210-36

N.S. Frac 9a 100 MFC + 3 BWph

Temp Abd.