

Section 18 Township 31 Range 40 WWell No. # 1 BreedingCompany Huber Corp

	0						

NORTH

WEST

EAST

SOUTH

Morton

KANSAS

Sec. 18 Twp. 31 R. 40 W ✓Well No. # 1 Breeding Farm

Huber Corp

Company

Wildcat

Contractor

Ft. from N. Line

990


Ft. from S. Line

Ft. from E. Line

990

Ft. from W. Line

NE SW NW

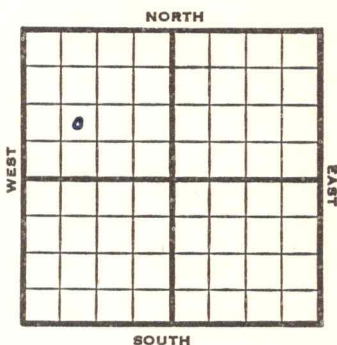

1953

Elev. 3334'

REPORT

Deep Test

8/5

Location

8/12

Drlg 75'

8/19

13" @ 505'

Anhy 1080', Win 2226', Tow 2274',
Drlg 2300'

9/2

N.R.

9/9

"

10/14

Spud 8-10-53

D & A

TD 5554'

13" @ 505'

Anhy 1080, Win 2226, Tow 2274,

TD 2300'

8" @ 2240'

DST 5375'-5445' opn 1 hr, rec 1800'

mud off KC 3540, Morrow 5090

TD 5553'

PB 2260

CO to 2286 B/ 25 bwph PB 2205

B/ 1/2 bwph SP 2220 CO to 2249

96/ 2226-46 SP 2215 500 A 3000 A

D & A

ABANDONED

County Morton State KansasSec. 18 (Blk.) 31 (Sur. Rge.) 40W Map No.Operator Huber Corp.Well No. 1 Farm BreedingElev. Location NE SW NW

990 Ft. From S Line NW990 Ft. From W Line Quarter1st. Report 4UG 5 1953

Completion


Remarks Deep test

Spudding Date

Drlg. Data Wildcat

Location

County Morton State Kansas
 Sec. 18 (Blk. 31 (Sur. 40W Map No.
 (Twp. (Rge.
 Operator Huber Corp.
 Well No. 1 Farm Breeding
 Elev. 3334 Location NE SW NW

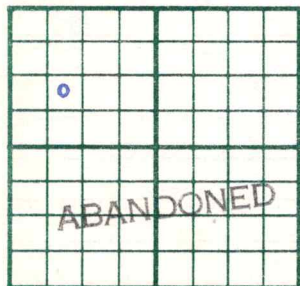

990 Ft. From S Line NW
990 Ft. From W Line Quarter

1st. Report

Completion OCT 14 1953

Remarks Wildcat

Spudding Date 8-10-53

Drlg. Data D & A TD 5554

13" @ 505 Anhy 1080 Win. 2226

Tow. 2274 TD 2300 8" @ 2240 DST 5375-

5445 open 1 hr. Rec. 1800' mud O#

KC 3540 Morrow 5090 TD 5553 PB 2260

CO to 2286 B/25 bwph PB 2205 B/ $\frac{1}{2}$ bwph

SP 2220 CO to 2249 96/ 2226-46

SP 2215 500 A 3000 A

D & A

J. G. McGEHEE