

FORM 51

Morton

KANSAS

32

31

40W

Section

Township


Range

Well No.

1 Steckel

Company

Kansas Natural Gas

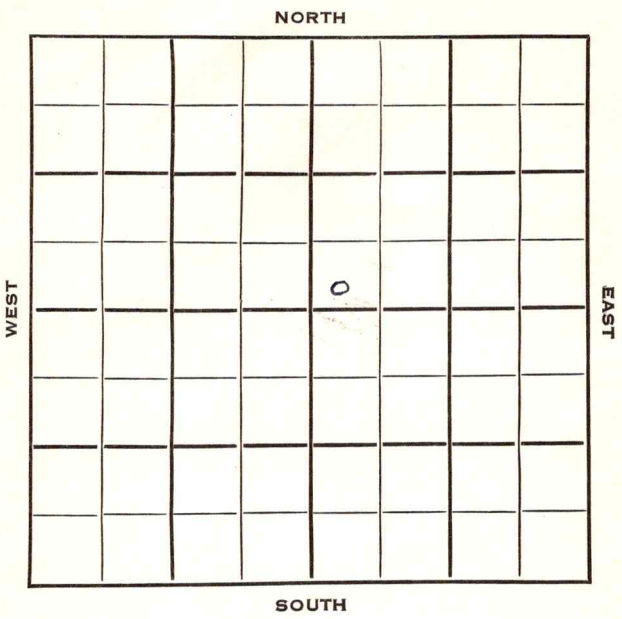

Morton

KANSAS ✓

Sec. 32 Twp. 31 R. 40^WWell No. #1 Steckel FarmKansas Natural Gas Company

Contractor

Ft. from N. Line

100


Ft. from S. Line

Ft. from E. Line

100

Ft. from W. Line

SW NE

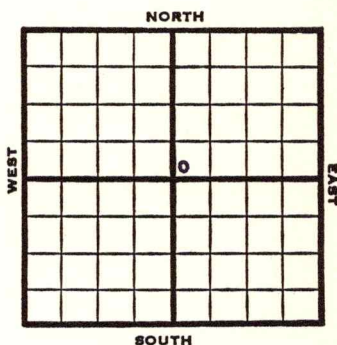

1953

Elev. 3317' REPORT

1/14

Location

1/22

"

1/29

"

2/5

"

2/12

"

2/19

"

2/26

Drlg. 320

3/12

10" @ 379

Her 2150, Kr 2108'?, Win 2212

RTD 2220

7" @ 2219

3/19

DD 2231, 120/2170-90

3/25

Spud 2-22-53

Gas Well

TD 2231

10" @ 379

Her 2150, Kri 2168, Win 2212,

TD 2220

7" @ 2219

DD 2231 120/2170-90 5000A

Comp. 10,360,000 gas

COMPLETED

County	Morton		State	Kansas	
Sec.	32	(Blk.) (Twp.)	31	(Sur.) (Rge.)	40W Map No.
Operator	Kansas Natural Gas				
Well No.	1	Farm	Steckel		
Elev.	3317	Location	SW NE		

100	Ft. From	S	Line	NE
100	Ft. From	W	Line	Quarter
1st. Report		JAN 14 1953		
Completion				
Remarks				
Spudding Date				

0

FIRST REPORT

Drig. Data

Location

J. G. McGEHEE

County Morton State KansasSec. 32 (Blk.
Twp.) 31 (Sur.
Rge.) 40W Map No.Operator Kansas Natural GasWell No. 1 Farm SteckelElev. 3317 Location SW NE

100 Ft. From S Line NE100 Ft. From W Line Quarter1st. ReportCompletion MAR 25 1953RemarksSpudding Date 2-22-53Drlg. Data Gas well TD 223110" @ 379 Her. 2150 Kri. 2168Win. 2212 TD 2220 7" @ 2219 DD 2231120/ 2170-90 5000 AComp. 10,360,000 gas