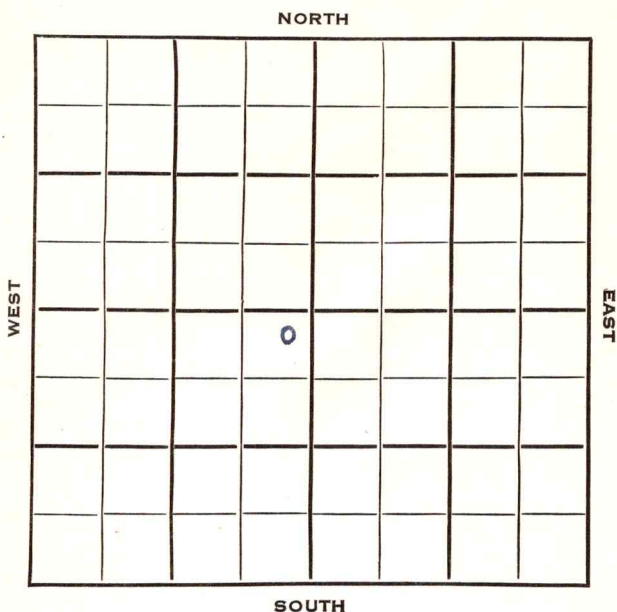


Section 31 Township 31 Range 40WWell No. 1 AmersonCompany Kansas Natural Gas

Morton

KANSAS

SEC.

TWP.

R.

31

31

40 W



WELL NO.

1 Amerson

FARM

COMPANY

Kansas Natural Gas

CONTRACTOR

Hugoton Pool

150

Ft. from N. Line

Ft. from S. Line


150

Ft. from E. Line

Ft. from W. Line

NE NE SW

NORTH

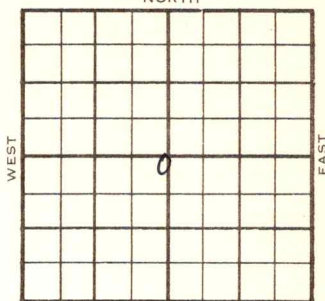

SOUTH

ELEVATION

REPORT

1954

3329'

3/3

Spud 2-27-54

10" @ 399

Drlg. 402'

3/10

RTD 2270'

Her. 2178', Kr. 2180', Win 2224'

7" @ 2265'

3/17

CO 2260

168/ 2224-52 500 M-A 1,729,000

gas frac. 5 M gas frac. 5,618,000

3/31

Spud 2-27-54 Gas well TD 2270

10" @ 399 Her. 2178 Kri. 2180

Win. 2224 TD 2270 7" @ 2265

CO to 2260 168/2224-52 500 mud-acid

1,729,000 gas frac. MCFG Frac.

5,618,000 gas. SP 2210 84/2174-88

24/2192-96 6 1/2 MCFG 5000 A frac.

CO to 2270 Comp. 11,125,000 gas.

COMPLETED

County **Morton** State **Kansas**

Sec. **31** (Blk. **31** (Sur. **40W** Map No.

Operator **Kansas Natural Gas**

Well No. **1** Farm **Amer 3 on**

Elev.	Location	NE	NE	SW

FIRST REPORT

150 Ft. From N Line SW

150 Ft. From E Line Quarter

1st. Report MAR 3 1954

Completion

Remarks

Spudding Date 2-27-54

Drlq. Data Hugoton Pool

10" @ 399 drlg. 402

J. G. McGEHEE

County Morton State KansasSec. 31 (Blk. 31 (Sur. 40W Map No.)
(Twp.) (Rge.)Operator Kansas Natural GasWell No. 1 Farm AmersonElev. 3329 Location NE NE SW150 Ft. From N Line SW150 Ft. From E Line Quarter1st. Report MAR 31 1954Completion Remarks Hugoton PoolSpudding Date 2-27-54Drlg. Data Gas well TD 227010" @ 399 Her. 2178 Kri. 2180Win. 2224 TD 2270 7" @ 2265CO to 2260 168/ 2224-52 500 mud-acid1,729,000 gas frac mcfg frac5,618,000 gas SP 2210 84/ 2174-8824/ 2192-96 6½ mcfg 5000 A fracCO to 2270 Comp. 11,125,000 gas

J. G. McGEHEE