


Morton

KANSAS

SECTION 14 TOWNSHIP 31 RANGE 41W

WELL NO. #1-14 Cunningham

COMPANY Panhandle Eastern

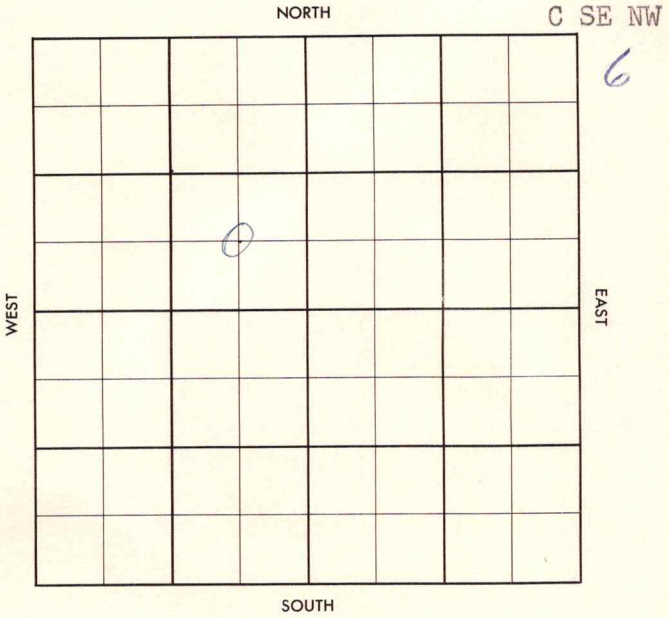

County Morton Elev. 3369 GRSec. 14 Twp. 31 Rge. 41WCompany Panhandle EasternFarm Name Cunningham No. 1-14

TOPS

DEPTH

LOG

DATUM

Loc. in Sec. \_\_\_\_\_

Anh.

C SE NW

Tp.

H.

Miss test

Tr.

Dg.

Bl.

L.

K.C.

Geol. \_\_\_\_\_

B.K.C.

Contr. \_\_\_\_\_

Ce.

C.

Garvey Tools

M.

Pool

M.

K.

Murphy

Mz.

Mq.

V.

S.

S.

A.

R.

P.E.

G.

T.D.

APR 17 '57

0

FIRST REPORT

Date Comm. 4-14-57Drlg. 575

34



CO 8/5391-93 \$ 2 GWPH  
 12/5388-91 \$ WTR NO/925  
 1/2 \$ 175 GWPH + 556 TSTM

MAY 29 '57 5Qd CO 5374 40/  
 5359-69 1/2 ga 171 MCLFL  
 1 ga 388 MCLFL JUN 5 '57

FRAC 5 X 2 1/2 ga 584  
 MCF W + T JUN 12 '57 JUN 19 '57 JUN 26 '57

JUL 3 '57 JUL 10 '57 JUL 17 '57 JUL 24 '57 JUL 31 '57 AUG 8 '57

AUG 14 '57 AUG 21 '57 AUG 28 '57 SEP 4 '57 SEP 11 '57

SEP 18 '57 SEP 25 '57 OCT 2 '57 OCT 9 '57 OCT 16 '57

OCT 23 '57 OCT 30 '57 NOV 6 '57 NOV 13 '57 NOV 20 '57

NOV 27 '57 DEC 4 '57 DEC 11 '57 DEC 18 '57

DEC 26 '57 JAN 2 '58 JAN 8 '58 JAN 15 '58 JAN 22 '58

JAN 29 '58 FEB 5 '58 FEB 12 '58 FEB 19 '58 FEB 26 '58

MAR 5 '58 MAR 12 '58 MAR 19 '58 MAR 26 '58 APR 2 '58

APR 9 '58 APR 16 '58 APR 23 '58 51 gas well

ga 866 mcf

MORSD 5359-69

P13 5374