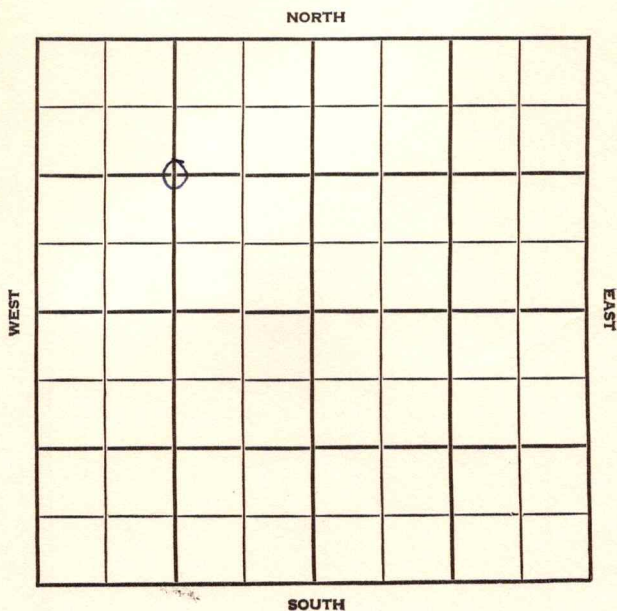


Section 4 Township 31 Range 42 WWell No. #1 Herron Gas UnitCompany Superior Oil

Morton		KANSAS	
SEC. 4	TWP. 31	R. 42W	
WELL NO. #1 Herron Gas Unit			
COMPANY Superior Oil			FARM
CONTRACTOR			

Sparks


_____ Ft. from N. Line

_____ Ft. from S. Line

_____ Ft. from E. Line

_____ Ft. from W. Line

C NW/4

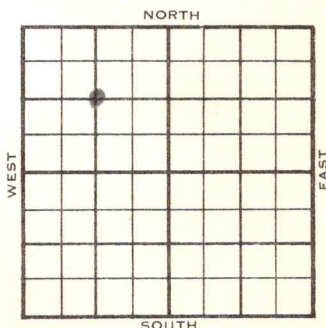

	ELEVATION	REPORT
1955	3510'	
8/3	Location	FIRST REPORT
10/12	Comm 9-5-55 10" @ 1367/800 7" @ 5335	
	Morrow	5144 5146
	Por	5226 5235
	M	5293 5293
	TD	5320 5316
	4/5250-51 Halliburton Form Test 5250-51 open 1½ hr gas in 2 min. 2,920 mcfg in 1½ hr Rec 1' diesel oil 1260/20" 76/5251-70 250 A S/load frac Comp open flow 22,500 mcfgpd 1125#	
	COMPLETED	

County Morton Elev. _____
 Sec. 4 Twp. 31 Rge. 42W
 Company Superior Oil
 Farm Name Herron Gas Unit No. 1

TOPS	DEPTH	LOG	DATUM	Loc. in Sec.
Anh.				C NW/4
Tp.				
H.				
Tr.				
Dg.				
B.L.				
L.				Geol.
K.C.				Contr.
B.K.C.				
Ce.				
C.				
M.				Pool
M.				Sparks
K.				
Mz.				
Ma.				
V.				
S.				
S.				
A.				
R.				
Pe.				
G.				
T.D.				

Date Comm.

Location

34

County Morton Elev. 3510
 Sec. 4 Twp. 31 Rge. 42W
 Company Superior Oil
 Farm Name Herron Gas Unit No. 1

TOPS	DEPTH	LOG	DATUM	Loc. in Sec.
Anh.				C NW/4
Tr.				
Tr. <u>Morrow</u>	<u>5144</u>	<u>5146</u>	<u>1636</u>	
Dg. <u>(Per)</u>	<u>5226</u>	<u>5235</u>	<u>1725</u>	
Bl.				
L.				
M.C.				Geol.
B.K.C.				Contr.
Ce.				
C.				
M.	<u>5293</u>	<u>5293</u>	<u>1783</u>	
M.				Pool
K.				Sparks
Mz.				
Me.				
V.				
S.				
S.				
A.				
R.				
Pe.				
G.				
T.D.	<u>5320</u>	<u>5316</u>		

Date Comm. 9-5-55 OCT 12 1955
10" @ 1367/800 7" @ 5335 4/ 5250-51
 Halliburton ^{Formation} ~~Elev~~ Test 5250-51 open 1½ hr.
 gas in 2 min. 2,920 mcfg in 1½ hr.
 Rec. 1' diesel oil 1260/20" 76/ 5251-70
250 A S/ load frac
 Comp. open flow 22,500 mcfgpd 1125#