


Section 5 Township 31 Range 42W

Well No. 1 Hume Unit

Company Superior, Cater & Stevens

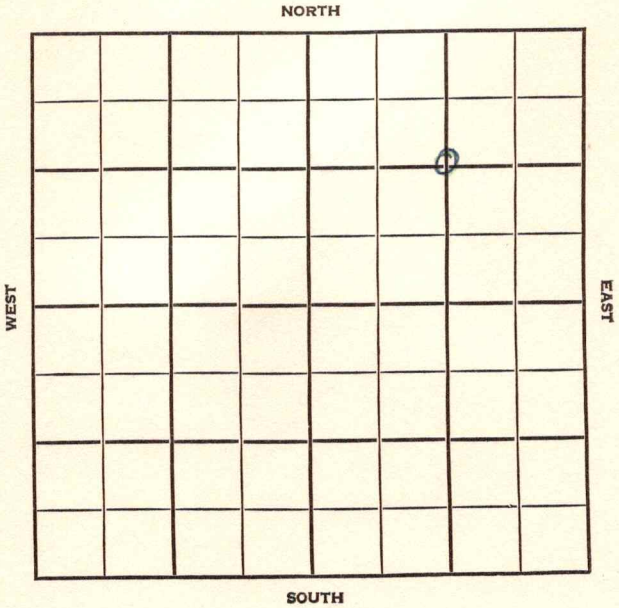

Morton

KANSAS

SEC.	TWP.	R.
5	31	42W

WELL NO.

#1 Hume Unit

FARM

COMPANY

Superior, Carter, & Stevens

CONTRACTOR

Reading & Bates


Sparks

_____ Ft. from N. Line

_____ Ft. from S. Line

_____ Ft. from E. Line

_____ Ft. from W. Line

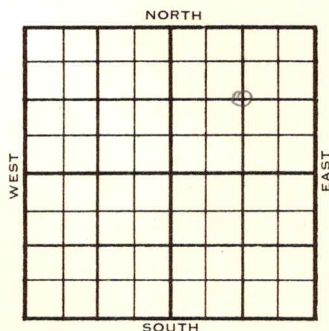

C NE/4

	ELEVATION	REPORT
1955	3525'	

7/6 Comm 5-5-55
 10 3/4" @1531/800 DST 3286-3379 failed
 DST 3246-3374 open 1 hr. Rec. 360' mud
 490/15 DST 5239-82 open 1 hr. gas in
 1 min. 1,310 mcf/gpd 5,210 mcf/g 45 min.
 Rec. 1 1/2" 1250/20" 7" @5332/350 CO to
 5320 200/5237-87 7,420 mcf/g 1/2 hr. 2,530
 mcf/g in 3 hr 500A 6,160 mcf/g 10,000A
 5,210 mcf/g Comp. 9,251 mcf/gpd

Tops:	Depth	Dog	Datum
Anh. Elm		3138	
Tp.	3278	3294	
H.	3558	3550	
Tr.	3596		
L.	3674	3680	155
BKC		4208	
Morrow Sd.	5148	5148	1623
M.		5298	1773
TD.	5330	5332	

**FIRST REPORT
 COMPLETED**

County Morton Elev. 3525
 Sec. 5 Twp. 31 Rge. 42W
 Company Superior, Carter & Stevens
 Farm Name Hume Unit No. 1

TOPS	DEPTH	LOG	DATUM
------	-------	-----	-------

Anh. <u>Elm</u>		<u>3138</u>	
Tp.	<u>3278</u>	<u>3294</u>	
H.	<u>3558</u>	<u>3550</u>	
Tr.	<u>3596</u>		
Dg.			
BL.			
L.	<u>13674</u>	<u>3680</u>	<u>15.5</u>
K.C.			
B.K.C. <u>Marm</u>		<u>4208</u>	
Ce.			
C.			
M. <u>arrow sd</u>	<u>5148</u>	<u>5148</u>	<u>1623</u>
M.		<u>5298</u>	<u>1773</u>
K.			
Mz.			
Me.			
V.			
S.			
S.			
A			
R.			
Pe.			
G.			
TD.	<u>5330</u>	<u>5332</u>	

Loc. in Sec.

C NE/4

Geol.

Contr.

Reading &

Bates

Pool

Sparks

**FIRST REPORT
COMPLETE**

Date Comm. 5-5-55

JUL 6 1955

10 3/4" @ 1531/800 DST 3286-3379

failed DST 3246-3374 open 1 hr.

Rec. 360' mud 490/15" DST 5239-82

open 1 hr. gas in 1 min. 1,310 mcf/gpd

5,210 mcf/g 45 min. Rec. 1 1/2'wm 1250/20"

7" @ 5332/350 CO to 5320/200

200/ 5237-87 7,420 mcf/g 1 1/2 hr.

2,530 mcf/g in 3 hr. 500 A 6,160 mcf/g

OVER

10,000 A 5,210 mcfg

Comp. 9,251 mcfgpd

Scout Cards	
Land Small Map	
Land Wall Map	
Tracings	
France Map	
Pierce Map	
Misc.	

[Handwritten signature]

JUL 18 1955