

25

31

42W

SECTION _____ TOWNSHIP _____ RANGE _____


WELL NO. #1 HaywardCOMPANY Petroleum Inc.

NORTH

C NE/4

WEST

EAST

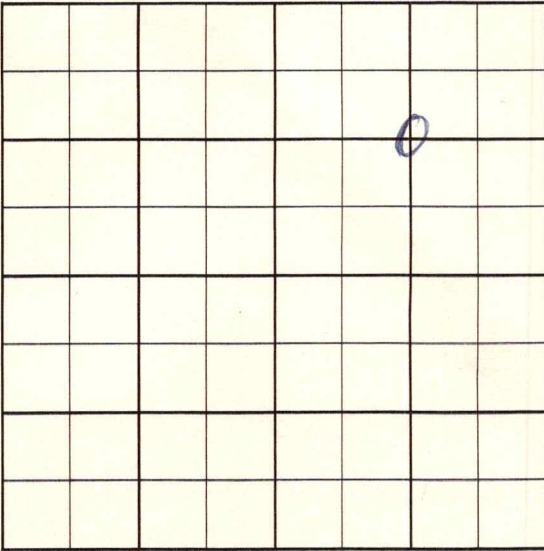

SOUTH

County Morton

Elev. _____

Sec. 25

Twp. _____

31

Rge. _____

42W

Company _____

Petroleum Inc.

Farm Name _____

Hayward

No. _____

1

TOPS

DEPTH

LOG

DATUM

Loc. in Sec. _____

Anb. _____

Tp. _____

H. _____

Tr. _____

Dg. _____

Bl. _____

L. _____

K.C. _____

B.K.C. _____

Ce. _____

C. _____

M. _____

M. _____

K. _____

Mz. _____

Mq. _____

V. _____

S. _____

S. _____

A. _____

R. _____

P.C. _____

G. _____

T.D. _____

C NE/4

Geol. _____

Contr. _____

Co. Tools

Pool _____

Sparks So.

JUN 12 '57

FIRST REPORT

Date Comm. 6-9-57

Colorado O & R (FO)

trip @ 1455

34

5400
3425
-1975

FORM 513 SUNRAY

County Horton Elev. 3425
 Sec. 25 Twp. 31 Rge. 42W
 Company Petroleum Inc.
 Farm Name Hayward No. 1

TOPS	DEPTH	LOG	DATUM	Loc. in Sec.
Anh. <u>WEd</u>	<u>2255</u>			<u>C NE/4</u>
Tp. <u>Wd</u>	<u>2865</u>			
H. <u>Elm</u>	<u>3145</u>			
Tr. <u>TP</u>	<u>3310</u>			
Dg. <u>Wd</u>	<u>3470</u>			
Bl. <u>Hd</u>	<u>3564</u>			
L. <u>TR</u>	<u>3595</u>			Geol. _____
K.C. <u>LSg</u>	<u>3678</u>			Contr. _____
B.K.C. <u>Marm</u>	<u>4500</u>			Co. Tools _____
Ce. _____	<u>4605</u>			Pool _____
C. <u>Mw</u>	<u>4885</u>			<u>Sparks So.</u>
M. <u>"G" sd</u>	<u>5180</u>			
M. _____	<u>5400</u>			
K. _____				
Mz. _____				
Mq. _____				
V. _____				
S. _____				
S. _____				
A. _____				
R. _____				
Pe. _____				
G. _____				
T.D. <u>5440</u>				ABANDONED

Date Comm. 6-7-57 Colorado O & R (FO)
 trip # 1455 JUN 19 57 3500 - 80/8
1495/80 MD 3500 DST 5210
-70 up 1 hr 20' Md FP 15-15
BHP 990/20" JUL 3 57 DST 5275-5315
90" rec 150' Md + 480' SW
FP 0-400 BHP 1300/20"

D E A