

SECTION 27 TOWNSHIP 31 RANGE 42W

WELL NO. #1 Clancy

COMPANY Lewis Drlg.

NORTH

C SW/4

WEST

EAST


SOUTH

County Morton

Elev. \_\_\_\_\_

Sec. 27

Twp. 31

Rge. 42W

Company Lewis Drlg.

Farm Name Clancy

No. 1

Co.

Lse.

No.

Sec.

T.

R.

TOPS	DEPTH	LOG	DATUM
Anb.			
Tp.			
H.			
Tr.			
Dg.			
Bl.			
L.			
K.C.			
B.K.C.			
Ce.			
C.			
M.			
M.			
K.			
Mz.			
Mo.			
V.			
S.			
S.			
A.			
R.			
PE.			
G.			
T.D.			

Loc. in Sec.

C SW/4

Geol. \_\_\_\_\_

Contr.

Lewis Drlg.

Pool


Greenwood

FIRST REPORT

APR 24 57  
24 57

Date Comm.

MIRT

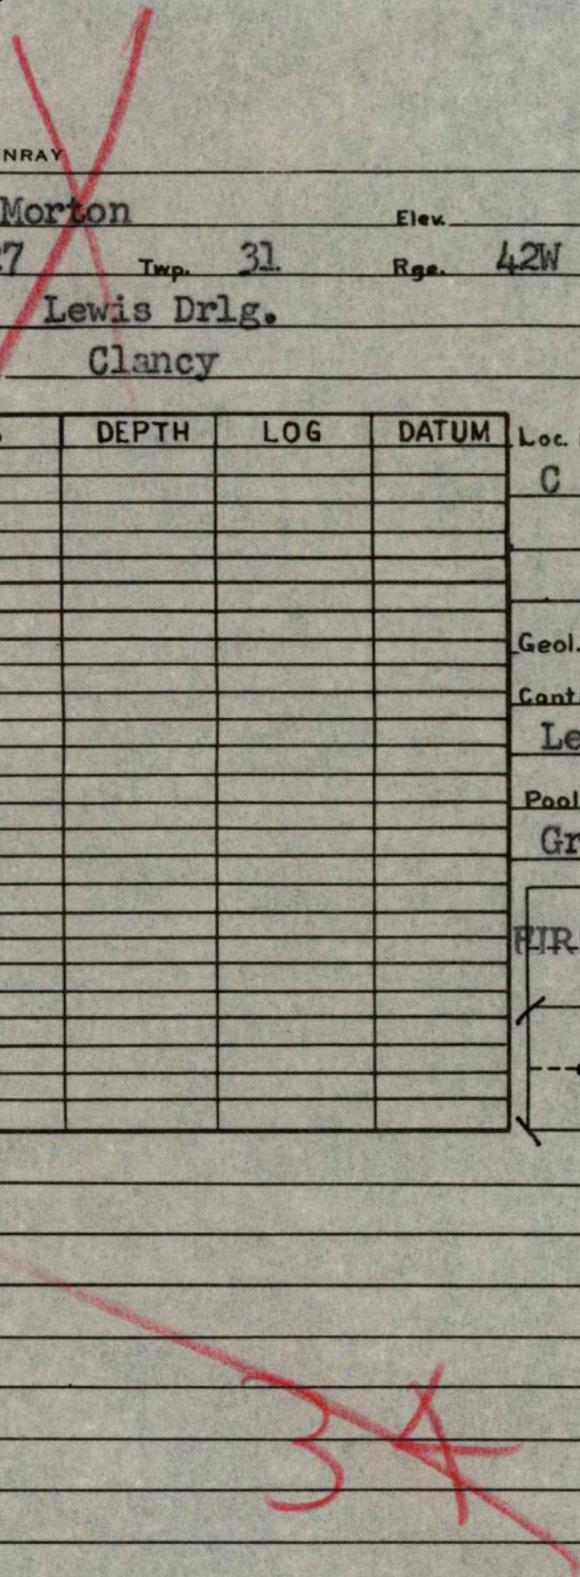

3456 DF

County Morton Elev. 3512 DF  
 Sec. 27 Twp. 31 Rgs. 42W  
 Company Lewis Drlg.  
 Farm Name Clancy No. 1

TOPS	DEPTH	LOG	DATUM	Loc. in Sec.
Anh. <u>W26</u>		<u>2719</u>		<u>C SW/4</u>
Tp. <u>ELM</u>		<u>2968</u>		
H. <u>TP</u>		<u>3132</u>		
Tr. <u>LC CP</u>	<u>3262</u>	<u>3162</u>		
Dg. <u>TC</u>		<u>3364</u>		
BL				
L.		<u>3447</u>		Geol.
K.C.				Cantr.
B.K.C.				<u>Lewis Drlg.</u>
Ce.				Pool
C.				<u>Greenwood</u>
M.				<div style="border: 1px solid black; padding: 5px; text-align: center;">                 JUN 5 57                  COMPLETE   </div>
M.				
K.				
Mz.				
Me.				
V.				
S.				
S.				
A.				
R.				
PE.				
G.				
TD. <u>3507</u>	<u>3510</u>			

Date Comm.

MIRT MAY 1 57 4 - 28 - 57 85/8  
 600/350 MAY 8 57 R79 Lag. MAY 15 57  
 5/2 3180 MIRT MAY 22 57 CO 32/  
 3130-38 1/2 9a 563 MCFG (5001)  
 PB 3120 76/3030-3100/9 9a  
 1,150 MCFG (dry) PB 3000 92/  
 2902-76 15 9a 2,470 MCFG  
 +10 GWP CO 3120 9a 4,150  
 MCF PB 2855 112/2773-2844

16 ga 1 Mill CFC CO 3120  
ga 5.280 M.C.F.G. PB 2765 88/  
2717-54 4/2 ga 10 Mill  
CFC CO 3120 ga 11.120  
M.C.F.G. SIP 450 <sup>MAY 29 57</sup> JUN 5 57  
ga 11.120 M.C.F.G. SIP 450#