


Morton

KANSAS

SECTION 28 TOWNSHIP 31 RANGE 42W

WELL NO. #1 Baughman

COMPANY Lewis Drlg.

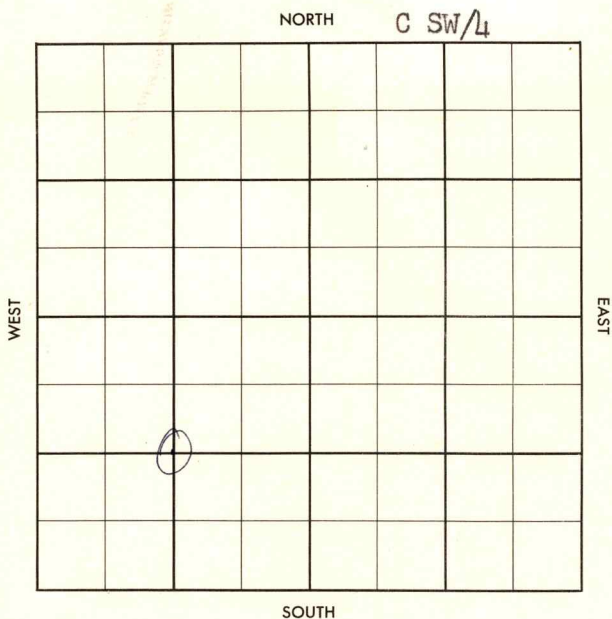

County Morton Elev. 3495  
 Sec. 28 Twp. 31 Rge. 42W  
 Company Lewis Drlg.  
 Farm Name Baughman No. 1

TOPS	DEPTH	LOG	DATUM	Loc. in Sec.
Anb.				C SW/4
TP.				
H. <u>Wd6</u>		<u>2732</u>		
Tr. <u>1-107</u>		<u>2985</u>		
Dg. <u>TP</u>		<u>2753</u>		
Bl. <u>Le cp</u>		<u>3283</u>		
L. <u>Hh</u>		<u>3363</u>		Geol.
K.C. <u>TR</u>		<u>3388</u>		Contr.
B.K.C. <u>LS9</u>		<u>3472</u>		Co. Tools
Ce.				Pool
C.				Greenwood
M.				<div style="border: 1px solid black; padding: 5px; text-align: center;"> <p>COMPLETE</p> <p>JUL 17 '57</p> </div>
M.				
K.				
Mz.				
Me.				
V.				
S.				
S.				
A.				
R.				
PE.				
G.				
TD	<u>3540</u>			

Date Comm. Colo. O & G - (FO)

M I R T MAY 22 '57 5-15-57 P57  
564/450 2085 MAY 29 '57 5 1/2 319/  
1800 JUN 5 '57 RUCT JUN 12 '57 CO 28/  
3116-23 20/3101-06 20/3085  
-90 20/3055-60 24/3038-44  
6 9a 500 MFL PB 3020  
104/ 2914-3000 5 1/2 9a  
350 MFL + 6 GW PB 2880  
80/ 2804-90 5 1/2 9a 350 MFL  
CO 3190 9a 520 MFL WD

10 ga 1,200 MCFL + 6 GWPB

JUN 19 '57

SOH 2990-3000

~~10~~ ~~27~~ ~~10~~ CO 3190 Bg P19

2780 16/2760-64 12/2756

-59 20/2748-53 16/2741-

45 14 ga 700 MCFL CO

3190 ga 1 MILL CFL JUN 26 '57

JUL 3 '57 JUL 10 '57 JUL 17 '57 or Flow

2,500 MCFL 5 days S.I. press

415 #

County Morton Elev. \_\_\_\_\_  
 Sec. 28 Twp. 31 Rge. 42W  
 Company Lewis Drlg.  
 Farm Name Baughman No. 1

TOPS	DEPTH	LOG	DATUM
Anh.			
Tr.			
H.			
Tr.			
Dg.			
Bl.			
L.			
K.C.			
B.K.C.			
Ce.			
C.			
M.			
M.			
K.			
Mz.			
Me.			
V.			
S.			
S.			
A.			
R.			
Pe.			
G.			
T.D.			

Loc. in Sec. C SW/4

Geol. \_\_\_\_\_  
 Contr. \_\_\_\_\_  
Co. Tools

Pool Greenwood

FIRST REPORT		MAY 15 57

Date Comm. \_\_\_\_\_ Colo. O & G - (FO)  
M I R T

~~DA~~

Co.

No.

Sec.

T.

R.