

Morton


KANSAS

SECTION 23 TOWNSHIP 31 RANGE 42W

WELL NO. #1-23 Hayward

COMPANY Colorado Oil & Gas


NORTH C NE

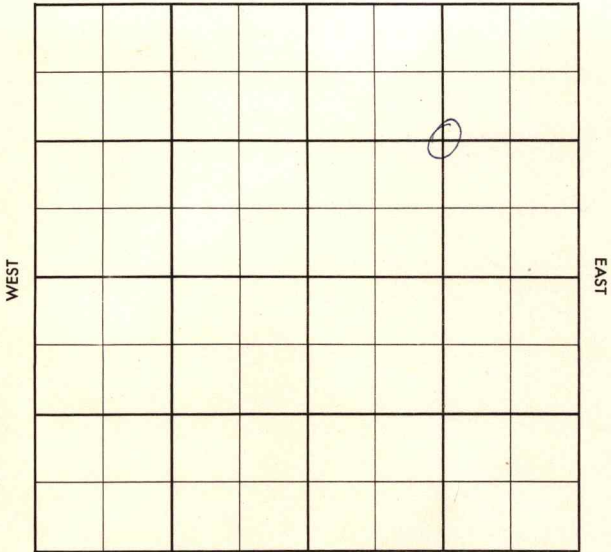

WILDCAT

County Morton Elev. _____
 Sec. 23 Twp. 31 Rge. 42W
 Company Colorado Oil & Gas
 Farm Name Hayward No. 1-23

TOPS	DEPTH	LOG	DATUM	Loc. in Sec.
Anh.				C NE
Tp.				Miss. test
H.				
Tr.				
Dg.				
Bl.				
L.				Geol.
K.C.				Contr.
B.K.C.				
Ce.				
C.				
M.				Pool
M.				Wildcat
K.				
Mz.				
Me.				
V.				
S.				
S.				
A.				
R.				
Pe.				
G.				
T.D.				

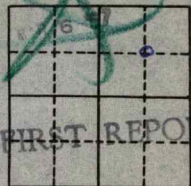

Date Comm. 3-1-57 Superior (DHM)
running 8", TTD 690

~~34~~

Co.
Lse.
No.
Sec.
T.
R.

5269
3478
-1791

FORM 513 SUNRAY

County Morton Elev. 3478
 Sec. 23 Twp. 31 Rge. 42W
 Company Colorado Oil & Gas
 Farm Name Hayward No. 1-23

TOPS	DEPTH	LOG	DATUM	Loc. in Sec.
Anh. <u>W286</u>		<u>2849</u>		<u>C NE</u>
TP	<u>3293</u>	<u>3290</u>		
H. <u>Le Camp</u>	<u>3436</u>	<u>3434</u>		<u>Miss. test</u>
Tr. <u>H6</u>		<u>3539</u>		
Dg. <u>TC</u>		<u>3569</u>		
Bl.				
L.	<u>3666</u>	<u>3649</u>		Geol.
K.C.				Concr.
B.K.C. <u>Martin</u>	<u>4443</u>	<u>4210</u>		
Ce. <u>MW 36</u>	<u>4815</u>	<u>4815</u>		
C. <u>REYER</u>	<u>5202</u>			
M. <u>MW 30</u>		<u>5105</u>		
M.				Pool <u>Superior</u>
K. <u>st Gen</u>		<u>5269</u>		<u>Wildcat</u>
M.L.				
Me				
V.				
S.				
S.				
A.				
R.				
PE.				
G.				
TD.	<u>5325</u>			COMPLETE

Date Comm. 3-1-57 Superior (D.H.M.)
 running 8", TTD 690 MAR 13 '57 MAR 20 '57
2975 8' 1509/850 DST 5125-85
of 90" run 20' GCM FP 35-35
BHP 998/30 DST 5205-35
of 70" G/3" ga 1.630 MCF
ga 2.190 MCF/35" ga 2.250
MCF/70" run 210' Dist cut Mud
FP 290-455 BHP 1240/30
5/20 5325/150 MAR 27 '57 CO PF

Co.
L.S.
No.
Sec.
T.
R.

5236-39 5 dry 100 gal acid
 to Frac APR 3 '57 1/4 5 SW + 55G
 8 No test 50d. APR 10 '57 CO 5234
 48/5196-5208 28/5221-28
 ga 500 MCFG To Frac APR 17 '57
 Frac ga. 3.50 MCFG + 50 G Load
 wt APR 24 '57 72-20 ga 10.617
 MCFG PD SIP 1265#