

Morton


KANSAS

SECTION 31 TOWNSHIP 31 RANGE 42 W

WELL NO. #1 Schrader Unit

COMPANY Colorado O & G & Superior

NORTH

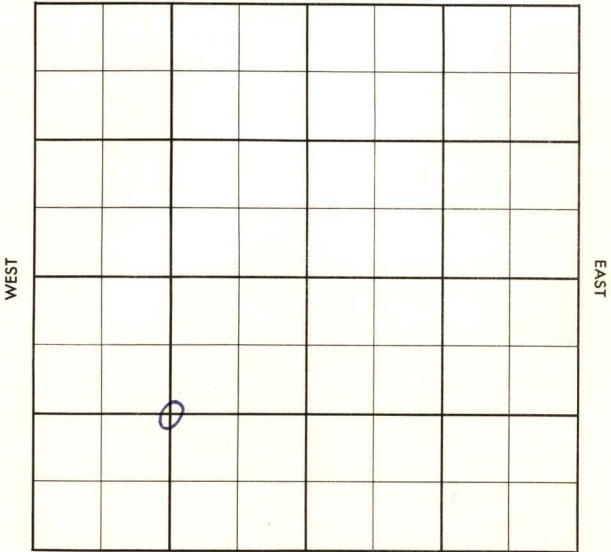

SOUTH

Morton

KANSAS

SEC. 31	TWP. 31	R. 42W
------------	------------	-----------

WELL NO.

#1 Schrader Unit

FARM

COMPANY

Colorado O&amp;G &amp; Superior

CONTRACTOR


\_\_\_\_\_ Ft. from N. Line

\_\_\_\_\_ Ft. from S. Line

\_\_\_\_\_ Ft. from E. Line

\_\_\_\_\_ Ft. from W. Line

C SW/4

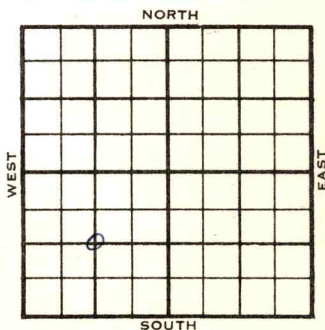

	ELEVATION	REPORT
1955	3549'	
11-30	Comm. 11-26-55 <del>10" @ 684/450</del> 10" @ 684/450	
1956		
1-18-	7" @ 3629-450 CO to 3580, 48/ 3560-68 S/ 6 bbls. diesel oil, 3000 A S/ 120 bsw, CO 48/ 3162-66, 1000 A CO 4/ 3068-69, 40/ 3068-73, 24/ 3096-99, 30/ 3108-16, 3122-26, 492 mcfg, frac, 652 mcfg, SP 3048, CO 48/ 3000-06 S/ dry 1000 A, frac, S/ 24 hrs. S/dry 1000 A, frac S/ 24 hrs. S/ sw 8 hrs., PB 2942, 4/ 2769-70 SP 2751, 24/ 2769-72, 24/ 2783-86 40/ 2802-07, 2000 A S/ SP 2748 CO to 3048, SP 2975, CO to 3096 CO to 3099, 40/ 3068-73, 1500 A, wtr. Co 24/ 3096-99, 40/ 3108-13, 32/ 3122-26, 1500 A, 345 mcfg, 1 1/4 bwph Comp. 277 mcfgpd	Waub 2749 Elmont 2996 Top 3160 LeComp 3293 L. 3531 TD 3630'

DX-78

COMPLETED

County Morton Elev. \_\_\_\_\_  
 Sec. 31 Twp. 31 Rge. 42W  
 Company Colorado O & G & Superior  
 Farm Name Schrader Unit No. 1

TOPS	DEPTH	LOG	DATUM
Anh.			
Tp.			
H.			
Tr.			
Dg.			
Bl.			
L.			
K.C.			
B.K.C.			
Ce.			
C.			
M.			
M.			
K.			
Mz.			
Mq.			
V.			
S.			
S.			
A.			
R.			
Pe.			
G.			
T.D.			

Loc. in Sec. C SW/4

Geol. \_\_\_\_\_

Contr. \_\_\_\_\_

Pool \_\_\_\_\_

NOV 30 1955  
 FIRST REPORT

Date Comm. 11-26-55  
10" @ 684/450

~~54~~

Co.

Lse.

T. No.

Sec.

T.

R.

County Morton Elev. 3549  
 Sec. 31 Twp. 31 Rge. 42W  
 Company Colorado O & G & Superior  
 Farm Name Schrader Unit No. 1

TOPS	DEPTH	LOG	DATUM
Anh.			
Tp. <u>Wank</u>		<u>2749</u>	
H. <u>Elmont</u>		<u>3756</u>	
Tr. <u>Top</u>		<u>3760</u>	
Dg. <u>to Caprup</u>		<u>3293</u>	
Bl.			
L.		<u>3531</u>	
K.C.			
B.K.C.			
Ce.			
C.			
M.			
M.			
K.			
Mz.			
Me.			
V.			
S.			
S.			
A.			
R.			
PE.			
G.			
T.D.	<u>3630</u>		

Loc. in Sec. C SW/4

Geol. \_\_\_\_\_

Contr. \_\_\_\_\_

Pool \_\_\_\_\_



Date Comm. 11-26-55 JAN 1 R 1956  
 10" @ 684/450 7" @ 3629/450 CO to 3580  
 48/ 3560-68 S/ 6 bbl. diesel oil 3000 A  
 S/ 120 bsw CO 48/ 3162-66 1000 A  
 CO 4/ 3068-69 40/ 3068-73 24/ 3096-99  
 30/ 3108-16 3122-26 492 mcfg frac  
 652 mcfg SP 3048 CO 48/ 3000-06  
 S/ dry 1000 A frac S/ 24 hr.  
 S/ sw 8 hr. PB 2942 4/ 2769-70

**OVER**

SP 2751 24/ 2769-72 24/ 2783-86

40/ 2802-07 2000 A S/ SP 2748

CO to 3048 SP 2975 CO to 3096

CO to 3099 40/ 3068-73 1500 A wtr.

CO 24/ 3096-99 40/ 3108-13

32/ 3122-26 1500 A 345 mcfg

1 $\frac{1}{4}$  bwph Comp. 277 mcfgpd

R. G.

JAN 27 1956